

Section 18 Township 9 Range 20WWell No. #1 MillerCompany Palmer Oil

NORTH

WEST

EAST

SOUTH

13

a

Rooks KANSAS

Sec. 18 Twp. 9 R. 20 W ✓

Well No. # 1 Miller Farm

Palmer Oil Company

Contractor


 Ft. from N. Line

330 Ft. from S. Line

 Ft. from E. Line

990 Ft. from W. Line

SE SW SW

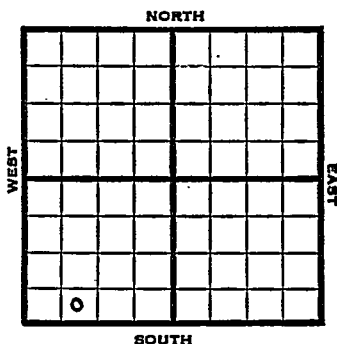

1951 Elev. 2237' REPORT

3/21 Location

6/20 Spud 3-31-51
Oil Well TD 3791

8" @ 153

Anhy 1754

Heeb. 3459

Tor. 3482

Lans. 3496

BKC 3710

Cong. 3756

Simp 3763

Arb. 3778

5" @ 3778

TD 3787

S/1/4 boph


1000 A

S/1/4 boph DD 3791 oil inc.

Comp. 116 bopd

COMPLETED

J. E. TYRA

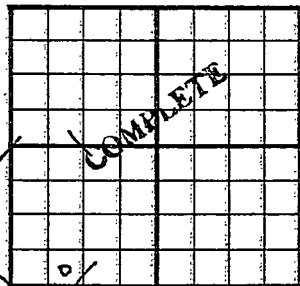County _____ Rocks _____ State KansasSec. 18 (Blk.
Twp.) 9 (Sur.
Rge.) 20W Map No. _____Operator Palmer OilWell No. 1 Farm MillerElev. 2237 Location SE SWSW330 Ft. From S Line SW990 Ft. From W Line Quarter1st. ReportCompletion JUN 20 1951RemarksMusgrove - Contr.Spudding Date 3-31-51Drilg. Data Oil well TD 37918" @ 153 Anhy 1754 Heeb. 3459Tor. 3482 Lans. 3496 B KC 3710Cong. 3756 Simp. 3763 Arb. 37785" @ 3778 TD 3787 S/ $\frac{1}{4}$ boph 1000 AS/ $\frac{1}{4}$ boph DD 3791 oil inc.Comp. 116 bopd