

Rooks

KANSAS

SEC. 18	TWP. 9	R. 20W
------------	-----------	-----------

WELL NO. #2 Miller FARM

COMPANY Skelly Oil Co.

CONTRACTOR Wentworth

GRA-Rooks


FT. FROM N. LINE

FT. FROM S. LINE

FT. FROM E. LINE

FT. FROM W. LINE

NE NE NW

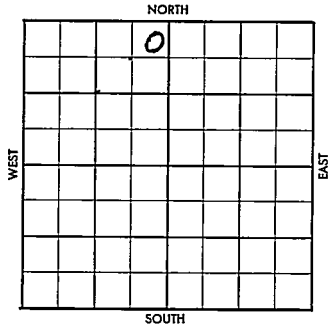

1956	ELEVATION	REPORT
------	-----------	--------

8-8 Location

COMPLETED

County Rooks Elev. 2236 DF
 Sec. 18 Twp. 9S Rge. 20W.
 Company Skelly Oil Co.
 Farm Name Miller No. 2

TOPS	DEPTH	LOG	DATUM	Loc. in Sec.																					
Anh.				NE NE NW																					
TP																									
H.	<u>3438</u>																								
Tr.	<u>3462</u>																								
Dg.																									
Bl.																									
L.	<u>3480</u>			Geol.																					
K.C.				Contr.																					
B.K.C.	<u>3701</u>			<u>Wentworth</u>																					
Ce.				Pool																					
C.	<u>3767</u>			<u>Gra-Rooks</u>																					
M.				<table border="1"> <tr><td></td><td>0</td><td></td></tr> <tr><td></td><td></td><td></td></tr> <tr><td></td><td></td><td></td></tr> <tr><td></td><td></td><td></td></tr> <tr><td></td><td></td><td></td></tr> <tr><td></td><td></td><td></td></tr> <tr><td></td><td></td><td></td></tr> </table>		0																			
	0																								
M.																									
K.																									
Mz.																									
Ma.																									
V.																									
S.																									
S.																									
A.	<u>3783</u>																								
R.																									
PC.																									
G.																									
TD.	<u>3795</u>			COMPLETE SEP 12 '56																					

Date Comm. Aug 15 '56
 Loc. 8-6-56 878 276
1175 2950 AUG 22 '56
DST 3758-95 1 hr. rec 125' HOCM
FP 35-75 BHP 830 572 @ 3784
1175 AUG 29 '56 CO 3795 TD FU
300' oil 3 hrs. No P. 63 BO +
6 BWS 2 1/2 hrs. SEP 5 '56 ✓ SEP 12 '56
Ph P. 131 Bopd + 6 1/2' with
gran 30°