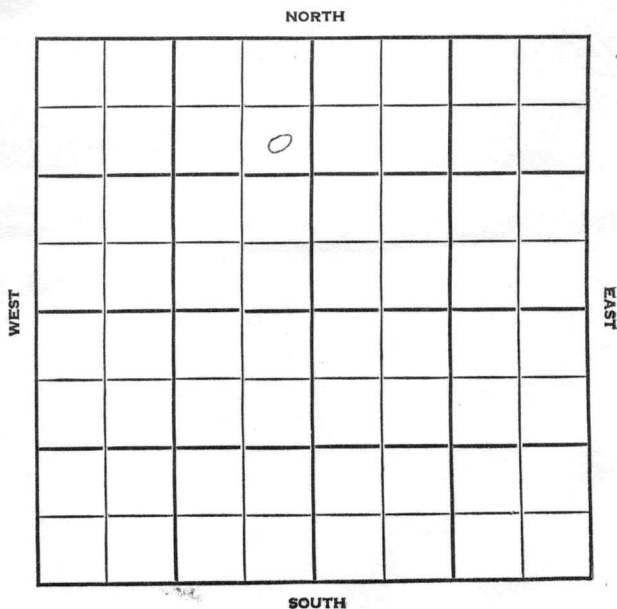


Section 18 Township 9 Range 20WWell No. #1 Paul MillerCompany Skelly Oil

SEC. 18	TWP. 9	R. 20W
------------	-----------	-----------

WELL NO.

#1 Paul Miller

FARM

COMPANY

Skelly Oil

CONTRACTOR

Wentworth

Gra-Rook


____ FT. FROM N. LINE

____ FT. FROM S. LINE

____ FT. FROM E. LINE

____ FT. FROM W. LINE

SE NE NW

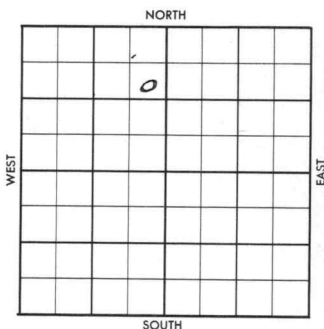

ELEVATION

1956

2243'

REPORT

7-25

Comm. 7-21-56

8" @ 279 w/175

WOC

8-15

5 $\frac{1}{2}$ " @ 3760 w/125

DD 3772

Tst 2 GO, 1 hr., 110 gal. acid;

Tst ~~XX~~ 15 GOPH, 4 hrs.

DD 3780

FU 350' oil, 2 hrs.,

P/ 1 $\frac{1}{2}$ BO, 3 hrs., no/wtr.

DD 3785

P/ 28 bo, no/wtr., 8 hrs.

P/ 85 bopd, no/wtr.

H. 3443'; Tr. 3468'; L. 3485';

BKC 3698'; S.Sh. 3754'; A. 3759';

TD 3764';

COMPLETED

County Rooks Elev. _____
 Sec. 18 Twp. 9 Rge. 20W
 Company Skelly Oil
 Farm Name Paul Miller No. 1

TOPS	DEPTH	LOG	DATUM
Anh.			
Tp.			
H.			
Tr.			
Dg.			
Bl.			
L.			
K.C.			
B.K.C.			
Ce.			
C.			
M.			
M.			
K.			
Mz.			
Mo.			
V.			
S.			
S.			
A.			
R.			
Pe.			
G.			
T.D.			

Loc. in Sec. _____

SE NE NW

Geol. _____

Contr. _____

Wentworth

Pool _____

Gra-Rook

JUL	25	1956
-----	----	------

FIRST REPORT

Date Comm. 7-21-563" @ 279/175 WOC

AUG 1 1956

R.G.

County Rock Elev. 2243
 Sec. 18 Twp. 1 Rge. 20W
 Company Skelly Oil
 Farm Name Paul Miller No. 1

TOPS	DEPTH	LOG	DATUM	Loc. in Sec.
Anh.				SE NW 1/4
Tr.				
H.	3443			
Tr.	3468			
Dg.				
Bl.				
L.	3485			
K.C.				Geol.
B.K.C.	3698			Contr.
Ce.				Wentworth
C.				
M.				Pool
M.				Cra-Pook
K.				
Mz.				
Mo.				
V.				
S. <u>5h</u>	3754			
S.				
A.	3759			
R.				
PE.				
G.				
TD.	3764			

COMPLETE

Date Comm. 7-21-56

AUG 15 '56

8" @ 279/175

WOC AUG 1 '56 @ 3500

AUG 8 '56 5 1/2 3760 / 125

AUG 15 '56 X DD 3772 Tst 260

1hr 110 gal acid Tst 15

Boph 4hrs DD 3780 FO 350'

oil 2hrs 1/2 P 1 1/2 BD 3 hrs

now DD 3785 TD 1/2 P. 28

Bo now 8hrs Ph P. P5 Bopd

now.