

Rooks

KANSAS

20W

SECTION 18 TOWNSHIP 9 RANGE 20W

WELL NO. #2 Towns Est.

COMPANY K & E Drlg.

NORTH

WEST

EAST

SOUTH

				0			

2

Rooks

KANSAS

SEC.	TWP.	R.
18	9	20W

WELL NO.

#2 Towns Est.

FARM

COMPANY

K & E Drlg.

CONTRACTOR

Co. Tools


WILDCAT

_____ Ft. from N. Line

_____ Ft. from S. Line

_____ Ft. from E. Line

_____ Ft. from W. Line

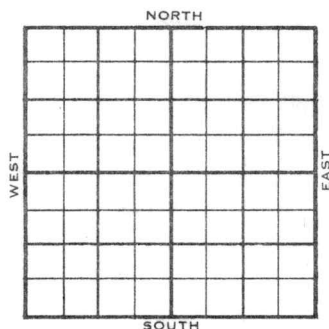

SW NW NE

Skelly - DHM

1956	ELEVATION	REPORT
	2220 DF	

5-23 Comm. 5-20-56
8" @ 201 w/140
Drlg. 1730
Anh. 1725'

7-18 DST 3731-43 op 1 hr, rec. 65' OCM,
580/15".
DST 3743-60 op 1 hr, rec. 265' HO&GCM,
960/15".
5½" @ 3746
CO 3760
P/ 2½ BOPH
P/ 96 BOPD, no/wtr.,
P/ 281 BOPD, no/wtr.
H. 3421'; L. 3462'; Weath. 3735';
Arb. 3749';
TD 3760'

COMPLETED

County	Rocks	Elev.		Co.
Sec.	18	Twp.	9	
Company	K & E Drig.	Rgs.	20W	
Farm Name	Towns Est.	No.	2	

TOPS	DEPTH	LOG	DATUM	Loc. in Sec.
Anh.	1725			SW NW NE
Tr.				
H.				
Tr.				
Dg.				
BL.				
L.				Geol.
K.C.				Contr.
B.K.C.				Co. tools
Ce.				Pool
C.				Wildcat
M.				
M.				
K.				
Mz.				
Me.				
V.				
S.				
S.				
A.				
R.				
PE.				
G.				
T.D.				

Date Comm.	5-20-56	Skelly DHM
8" @ 201/140	drig. 1730	

2221 R S YAM

2221 R S YAM

County Rooks Elev. 2220 DF
 Sec. 18 Twp. 9 Rge. 20W
 Company K & E Drilg.
 Farm Name Towns Est. No. 2

TOPS	DEPTH	LOG	DATUM	Loc. in Sec.
Anh.	1725			SW NW NE
TP.				
H.	3421			
Tr.				
Dg.				
Bl.				
L.	3462			Geol.
K.C.				Contr.
B.K.C.				Co. tools
Ce.				Pool
C.				Wildcat
M.				
M.				
K.				
Mz.				
Me.				
V.				
S.				
S.				
A. <u>WEATH.</u>	3735			0 COMPLETE JUL 18 1956
R. <u>Arb</u>	3749			
Pe.				
G.				
TD.	3760			

Date Comm. 5-20-56 Skelly DHM

8" @ .201/140 drilg. 1730 MAY 29 '56

DST 3731-43 1hr rec 65'

OCM 580/15" DST 3743-60

1hr rec. 265' HO & 6 CM 960/

15" 5 1/2 @ 3746 JUN 6 '56

~~See last test~~ JUN 13 '56 JUN 20 '56

CO 3760 P. 2 1/2 Bopd JUN 27 '56

P. 96 Bopd no/water JUL 3 '56

JUL 11 '56 JUL 18 '56 Ph P. 281 Bopd no/water