


Section 18 Township 9 Range 20W

Well No. #4 Towns Est.

Company K & E Drlg.

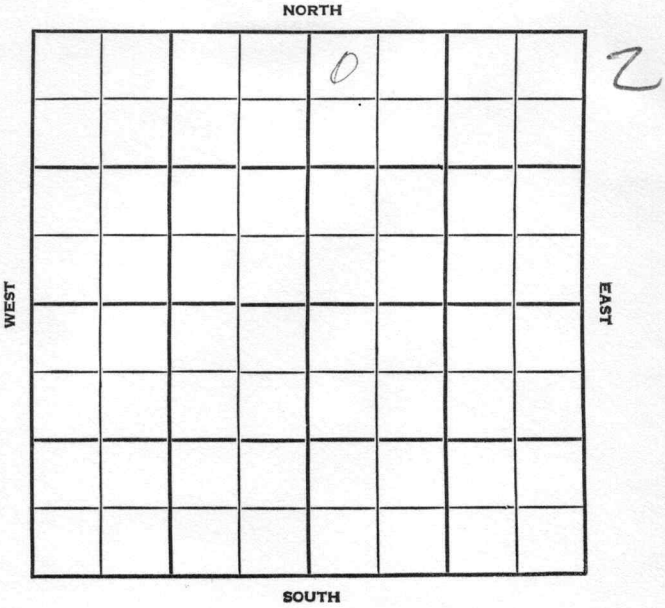

County Rooks Elev. _____
 Sec. 18 Twp. 9 Rge. 20W
 Company K. & E. Drlg.
 Farm Name Towns EST No. 4

TOPS	DEPTH	LOG	DATUM
Anh.			
Tp.			
H.			
Tr.			
Dg.			
Bl.			
L.			
K.C.			
B.K.C.			
Ce.			
C.			
M.			
M.			
K.			
Mz.			
Ma.			
V.			
S.			
S.			
A.			
R.			
Pe.			
G.			
T.D.			

Loc. in Sec. _____
 NW NW NE
 Geol. _____
 Contr. _____
 Co. Tools _____
 Pool _____
 Gray Rooks

	6	

FIRST REPORT
 OCT 24 1956

Date Comm. spd. 10-20-56
Drlg. 2525

~~NOV 5 1956~~
~~R.G.~~

Co.
 Sec.
 No.
 Sec.
 T.
 R.

CORRECTION

FORM 513 SUNRAY

County Rooks Elev. 2217
 Sec. 18 Twp. 9 Rge. 20W
 Company K. & E. Drlg.
 Farm Name Towns EST No. 4

TOPS	DEPTH	LOG	DATUM	Loc. in Sec.
Anh.	1720			NW NW NE
Tr.				
H.	3425			
Tr.	3449			
Dg.				
Bl.				
L.	3465			
K.C.				Geol.
B.K.C.				Contr.
Ce.				Co. Tools
C.	3736			
M.				Pool
M.				Gray Rocks
K.				
Mz.				
Mo.				
V.				
S.				
S.				
A.	3780			
R.				
PE.				
G.				
TR.	3790			

0

NOV 7 '56

ABANDONED

Date Comm. spd. 10-20-56 8 5/8 210 / 140
 Drlg. 2525 OCT 31 '56 DST 3783-90
1 hr rec 20' Md + 5' SOCM
BHT 100 NOV 7 '56

D&A