


Section 18 Township 9 Range 20 W

Well No. # 5 Towns

Company Skelly

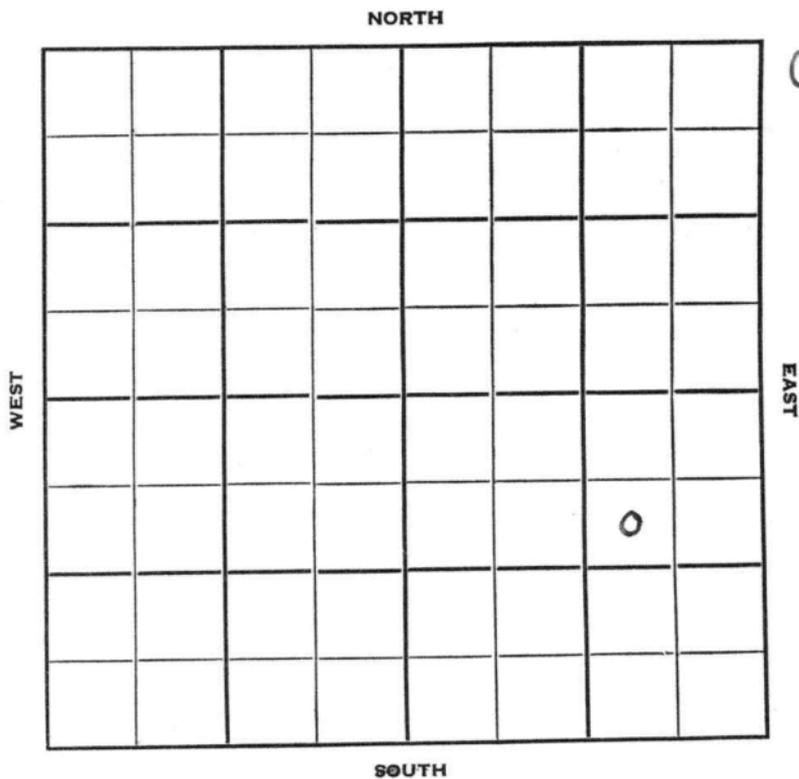

Sec. 18 Twp. 9 R. 20 W ✓

Well No. # 5 Towns Farm

Skelly Company

Contractor

Palco


990 Ft. from N. Line

Ft. from S. Line

990 Ft. from E. Line

Ft. from W. Line

SW NE SE

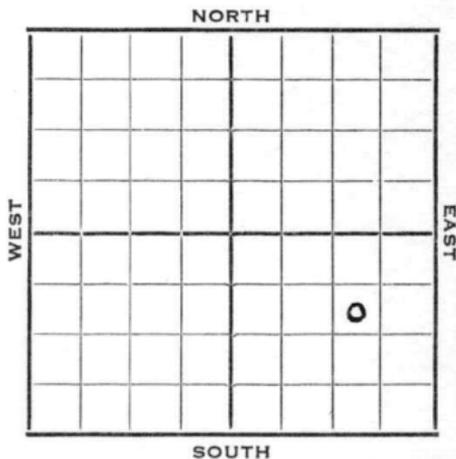

1952 Elev. 2248' REPORT

2/27 Location  
 3/5 8" @ 290' WOC  
 3/12 Drlg. 2410'  
 3/19 Spud 3-1-52  
 D&A TD 3910  
 8" @ 290  
 Heeb. 3474                      Lans. 3513  
 Cong. 3785                      TD 3910  
 D&A

**ABANDONED**



