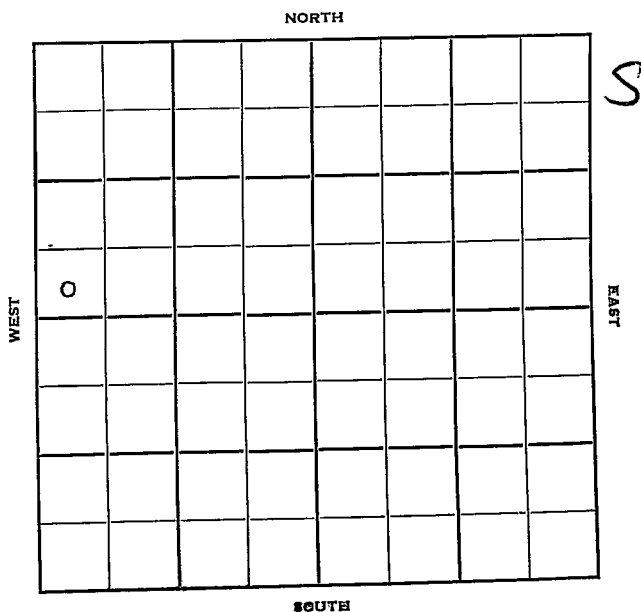


Section 18 Township 9 Range 21WWell No. #1 ForgyCompany R. W. Shields

Graham

KANSAS

Sec. 18 Twp. 9 R. 21 W ✓

Well No. # 4 Forgy Farm

R. W. Shields Company

Barnett Drlg. Contractor

Morel Pool


 Ft. from N. Line

330 Ft. from S. Line

 Ft. from E. Line

330 Ft. from W. Line

SW SW NW

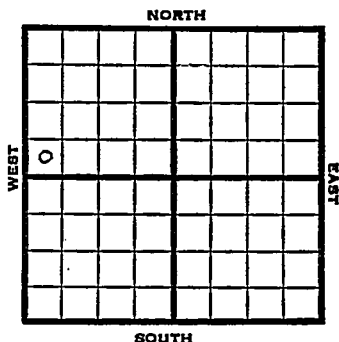

1951

Elev. 2312' REPORT

8/8

Spud 8-4-51

8" @ 145'

Drlg. 1500'

9/26

Spud 8-4-51

Oil well TD 3831½'

8" @ 145'

Anhy 1798' Heeb. 3481' KC 3522'

DST 3524-38 open 1 hr.

Rec. 55' sw TD 3830'

Arb. 3828'

5" @ 3830 DD 3831½' FU 2300'

oil 1 hr. S/ 26 boph 2 hr.

Comp. deptho. pot. 3000 bopd

COMPLETED
~~CORRECTION~~

County Graham State KansasSec. 18 (Blk. Twp.) 9 (Sur. Rge.) 21W Map No.Operator R. W. ShieldsWell No. 4 Farm ForgyElev. 2312 Location SW SW NW

0					

330 Ft. From S Line NW330 Ft. From W Line Quarter1st. Report AUG 8 1951

Completion

Remarks

Barnett Drlg. - Contr.Spudding Date 8-4-51Drlg. Data Morel Pool8" @ 145 drlg. 1500

J. E. TYRA

County Graham State Kansas
 Sec. 18 (Blk. Twp.) 9 (Sur. Rge.) 21W Map No. _____
 Operator R. W. Shields
 Well No. 4 Farm Forgy
 Elev. 2312 Location SW SW NW

0							

330 Ft. From S Line NW

330 Ft. From W Line Quarter

1st. Report

Completion SEP 26 1951

Remarks Morel Pool

Barnett Drlg. - Contr.

Spudding Date 8-4-51

Drlg. Data Oil well TD 3831 $\frac{1}{2}$

8" @ 145 Anhy 1798 Heeb. 3481

KC 3522 DST 3524-38 open 1 hr.

Rec. 55' sw TD 3830 Arb. 3828

5" @ 3830 DD 3831 $\frac{1}{2}$ FU 2300' oil 1 hr.

S/ 26 boph 2 hr.

Comp. deptho. pot. 3000 bopd