

Graham

KANSAS

FORM 51 25M 3-49 PETROL

Section 18 Township 9 Range 21W

Well No. #6 Forgy

Company R. W. Shields

NORTH

2							

WEST

EAST

SOUTH

4

Graham

KANSAS

Sec. 18 Twp. 9 R. 21W

Well No. #6 Forgy Farm

RW Shields

Company

Barnett Drlg.

Contractor

990

Morel Pool

NORTH


Ft. from N. Line

Ft. from S. Line

Ft. from E. Line

330

Ft. from W. Line

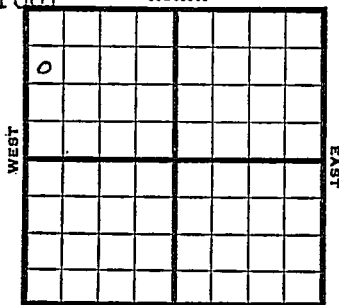

SW NW NW

1951

Elev. 2288'

REPORT

10/24

Spud 10-21-51

8" @ 128'

Drlg. 900'

12/19

Spud 10-21-51

Oil Well TD 3821

8" @ 128

Heeb. 3466

Lans. 3500

B KC 3709

Arb. 3816

TD 3821 5" @ 3816 CO to 3821

FU 1600 oil 850' wtr. 24 hr.

Comp. 32 BOPD 74% wtr.

COMPLETED

County Graham State Kansas
 Sec. 18 (Blk. Twp.) 9 (Sur. Rge.) 21W Map No. _____
 Operator R. W. Shields
 Well No. 6 Farm Forgy
 Elev. _____ Location SW NW NW

0							

990 Ft. From N Line NW

330 Ft. From W Line Quarter

Ist. Report OCT 24 1951

Completion _____

Remarks _____

Barnett Drlg. - Contr.


Spudding Date 10-21-51

Drlg. Data _____

Morel Pool

8" @ 128 drlg. 900

J. E. TYRA

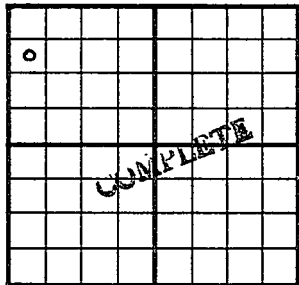County Graham State KansasSec. 18 (Blk. Twp.) 9 (Sur. Rge.) 21W Map No.Operator R. W. ShieldsWell No. 6 Farm ForgyElev. 2288 Location SW NW NW990 Ft. From N Line NW330 Ft. From W Line Quarter

1st. Report

Completion DEC 1 9 1951Remarks Morel PoolBarnett Drlg. - ContrSpudding Date 10-21-51Drlg. Data Oil well TD 38218" @ 128 Heeb. 3456 Lans. 3500B KC 3709 Arb. 3816 TD 38215" @ 3816 C⁰ to 3821 FU 1600'oil 850' water 24 hr.Comp. 32 bopd 74% water

J. E. FRYMAN