

Section 18 Township 9 Range 21WWell No. #1 SeefeldCompany Cities Service

							0

NORTH

WEST

EAST

SOUTH

Graham

KANSAS

Sec. 18 Twp. 9 R. 21W

Well No. #1 Seefeld Farm

Cities Service Company

Rine Drlg. Contractor

Morel Pool


 Ft. from N. Line

330' Ft. from S. Line

330' Ft. from E. Line

 Ft. from W. Line

SE SE NE

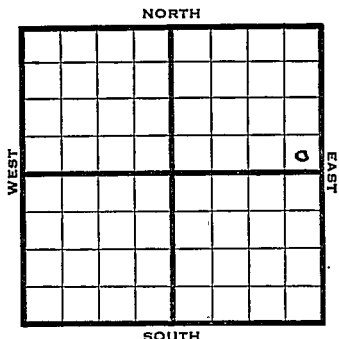

1950 2296 REPORT

4/26 Spud 4-22-50
8" @ 201'
Drlg. 2320'

5/17 TD 3797
8" @ 201
Lans 3491
Abr 3788
5" @ 3790
3000 BOPD
Completed

COMPLETED


Map No. _____ Sec. 18 Twp. 9 R. 21WWell No. 1 Seefeld

_____ Cities Service _____ Company

_____ Rine Drlg. _____ Contractor

SE SE NE

SECTION PLAT

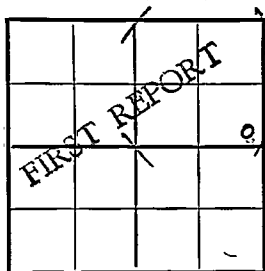

_____ Ft. from N. Line

330 _____ Ft. from S. Line330 _____ Ft. from E. Line

_____ Ft. from W. Line

Graham County

Location _____

Rig up _____

Drilling and Remarks:

Spud 4-22-50

8" @ 201

drlg. 2320

RECORD

Cased _____ in., _____ ft.

Sand _____

Gas _____

Oil _____

Total Depth _____

PRODUCTION

1st 24 hrs. Nat. _____

1st 24 hrs. after shot _____

Gas _____ Cu. Ft.

Dry Hole _____

Abandoned _____

Date


APR 26 1950 19

J. E. TYRA

Scout

Map No. _____ Sec. 18 Twp. 9 R. 21^WWell No. 1 SeefieldCities Service Company_____
Contractor

SE SE NE

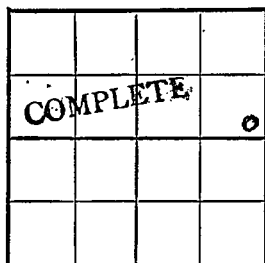E1. 2296
SECTION PLAT_____
Ft. from N. Line330 Ft. from S. Line330 Ft. from E. Line_____
Ft. from W. Line

Graham

Location _____

Rig up _____

Drilling and Remarks:

8" @ 201
 Loss 3491
 and 3788
 5" @ 3790
 3000 BOPD

RECORD

Cased _____ in., _____ ft.

Sand _____

Gas _____

Oil _____

Total Depth 3797

PRODUCTION

1st 24 hrs. Nat. _____

1st 24 hrs. after shot _____

Gas _____ Cu. Ft.

Dry Hole _____

Abandoned _____

Date

MAY 17 1950

19

J. E. TYRA

Scout