


Section 18 Township 9 Range 21-W

Well No. #4 Seefeld

Company Cities Service

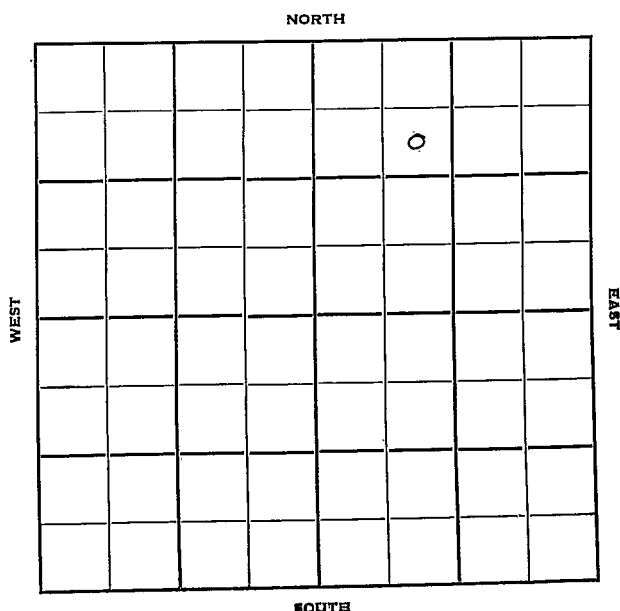

Sec. 18 Twp. 9 R. 21W

Well No. #4 Seefeld Farm

Cities Service

Company

Contractor

Morel Pool


990' Ft. from N. Line

Ft. from S. Line

Ft. from E. Line

990' Ft. from W. Line

SE NW NE

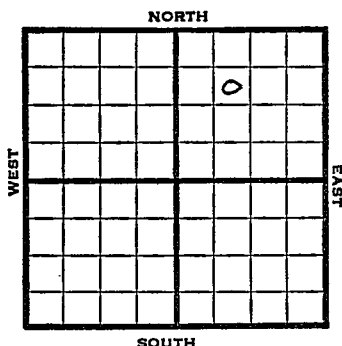

1950

Elv. 2280'

REPORT


9/20

Spud 9-15-50
8" @ 240
Drlg. 2475'

11/22

Spud 9-15-50
Oil Well TD 3798'
8" @ 240'
Lans. 3491' Arb. 3789'
TD 3793' 5" @ 3791'
DD 3798' FU 495' oil 2 hr
P 212 bo 12 hr.
Comp. 274 bopd

COMPLETED

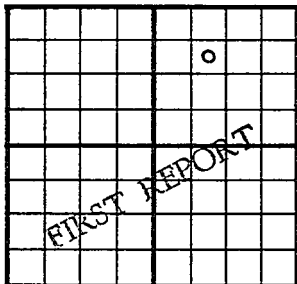County Graham State KansasSec. 18 (Blk. Twp.) 9 (Sur. Rge.) 21W Map No.Operator Cities ServiceWell No. 4 Farm SeefeldElev. 2280 Location SE NW NE990 Ft. From N Line NE990 Ft. From W Line Quarter1st. Report SEP 20 1950

Completion

Remarks

Spudding Date 9-15-50Drlg. Data Morel Pool8" @ 240 drlg. 2475

J. E. TYRA

County Graham State KansasSec. 18 (^{Blk.}_{Twp.}) 9 (^{Sur.}_{Rge.}) 21W Map No. _____Operator Cities ServiceWell No. 4 Farm SeefeldElev. 2280 Location SE NW NE

990 Ft. From N Line NE990 Ft. From ~~W~~ Line Quarter1st. ReportCompletion NOV 22 1950Remarks Morel PoolSpudding Date 9-15-50Drlg. Data Oil well TD 37988" @ 240 Lans. 3491 Arb. 3789TD 3793 5" @ 3791 DD 3798 FU 495' oil2 hr. P/ 212 bo 12 hr.Comp. 274 bopd