

KANSAS Graham

Section 18 Township 9 Range 21-WWell No. #6 SeefeldCompany Cities Service

NORTH

				0			

WEST

EAST

SOUTH

7

KANSAS

Sec. 18 Twp. 9 R. 21W

Well No. #6 Seefeld Farm

Cities Service Company

Morel Pool Contractor


 Ft. from N. Line

990' Ft. from S. Line

 Ft. from E. Line

330' Ft. from W. Line

NW SW NE

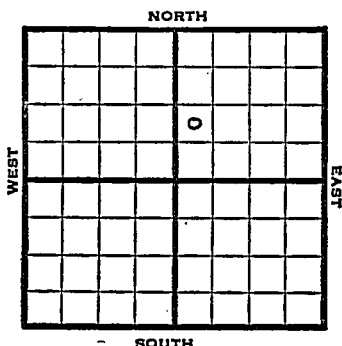

1950 Elev. 2308' REPORT

11/15

Spud 11-8-50
8" @ 240'
Drlg. 3585'

1951
1/3

Spud 11-8-50
Oil Well TD 3841
8" @ 240' Heeb. 3486
Lans. 3525' Ch. Cong. 3809
Arb. 3836' TD 3841
DST 3836-41 opn $\frac{1}{2}$ hr Rec. 430' oil
30' ocm 5" @ 3837
CO to 3841 FU 1560' fluid $3\frac{1}{2}$ hr
2805' in 15 hr P/99 bo 5 bw 15 hr
Comp. 167 bopd

COMPLETED

County Graham State KansasSec. 18 (Blk.) 9 (Sur.) 21W Map No.Operator Cities ServiceWell No. 6 Farm SeefeldElev. 2308 Location NW SW NE


990 Ft. From S Line NE330 Ft. From W Line Quarter1st. Report NOV 15 1950

Completion

Remarks

Spudding Date 11-8-50Drlg. Data Morel Pool8" @ 240 drlg. 3585

J. E. TYRA

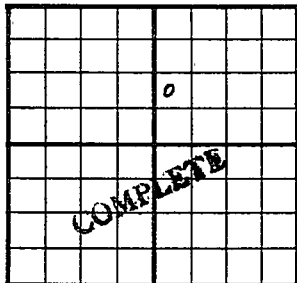County Graham State KansasSec. 18 (Blk. Twp.) 9 (Sur. Rge.) 21W Map No.Operator Cities ServiceWell No. 6 Farm SeefeldElev. 2308 Location NW SW NE990 Ft. From S Line NE330 Ft. From W Line Quarter

1st. Report

Completion JAN 3 1951Remarks Lorel PoolSpudding Date 11-8-50Drig. Data Oil well TD 38418" C 240 Heeb. 3486 Lans. 3525Ch. Cong. 3809 Arb. 3836 TD 3841DST 3836-41 open $\frac{1}{2}$ hr. Rec. 430' oil30' ocm 5" C 3837 CO to 3841 FU 1560'fluid 3 $\frac{1}{2}$ hr. 2805' in 15 hr.P/ 99 bo 5 bw 15 hr.Comp. 167 bopd

J. E. TYRA