


Section 18 Township 9 Range 21W

Well No. #3 Suttor "B"

Company Peel & Hardman

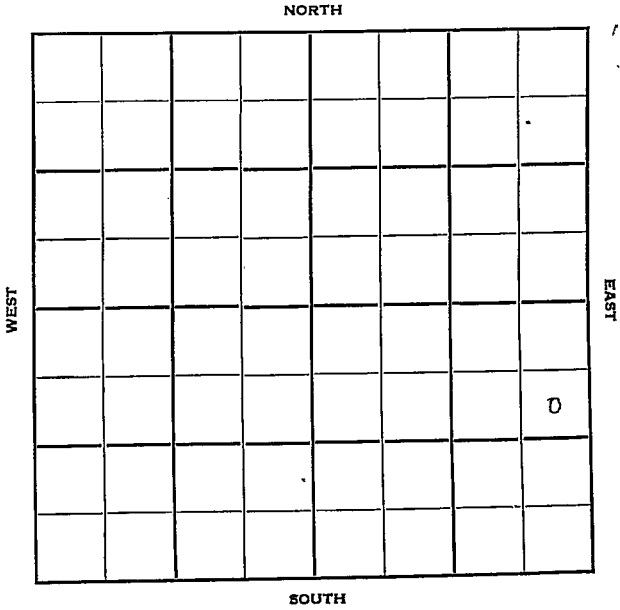

Graham

KANSAS

Sec. 18 Twp. 9 R. 21W

Well No. #3 Suttor "B" Farm

Reel & Hardman Company

Contractor


Morel Pool

990' Ft. from N. Line

Ft. from S. Line

330' Ft. from E. Line

Ft. from W. Line

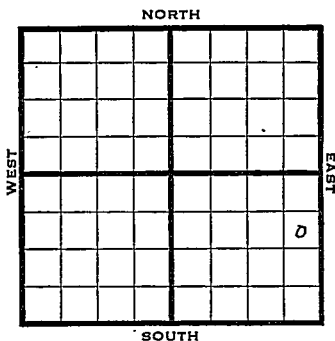

SE NE SE

1950

Elev 2284'

REPORT

3/22

Spud 3-18-50
8" @ 156'
Drlg. 1795'

5/3

TD 3800'
8" @ 156'
Lans 3487'
Arb. 3794'
5" @ 3794'
464 BOPD
Comp

COMPLETED

Map No. _____ Sec. 18 Twp. 9 R. 21W

Well No. 3 Suttor "B"

Peel & Hardman Company

Contractor

SE NE SE

SECTION PLAT

990 Ft. from N. Line

Ft. from S. Line

330 Ft. from E. Line

Ft. from W. Line

FIRST REPORT

Graham County

Location _____

Rig up _____

Drilling and Remarks:

Spud 3-18-50

8" @ 156

drlg. 1795

RECORD

Cased _____ in., _____ ft.

Sand _____

Gas _____

Oil _____

Total Depth _____

PRODUCTION

1st 24 hrs. Nat. _____

1st 24 hrs. after shot _____

Gas _____ Cu. Ft.

Dry Hole _____

Abandoned _____

Date

MAR 22 1950

19

J. E. TYRA

Scout

Map No. _____ Sec. 18 Twp. 9 R. 21WWell No. 3 Suttor "B"Peel & Hardman Company

Contractor

SE NE SE

EI. 2284
SECTION PLAT990 Ft. from N. Line

_____ Ft. from S. Line

330 Ft. from E. Line

_____ Ft. from W. Line

Graham County

COMPLETE			
			o

Location _____

Rig up _____

Drilling and Remarks:

8" @ 156
Lans 3487
amb 3794
5" @ 3794
464 BOPD

RECORD

Cased _____ in., _____ ft.

Sand _____

Gas _____

Oil _____

Total Depth 3800

PRODUCTION

1st 24 hrs. Nat. _____

1st 24 hrs. after shot _____

Gas _____ Cu. Ft.

Dry Hole _____

Abandoned _____

Date

MAY 3 1950

19

J. E. TYRA Scout