


Section 18 Township 9 Range 21 W

Well No. # 9 Forgy

Company Shields Oil

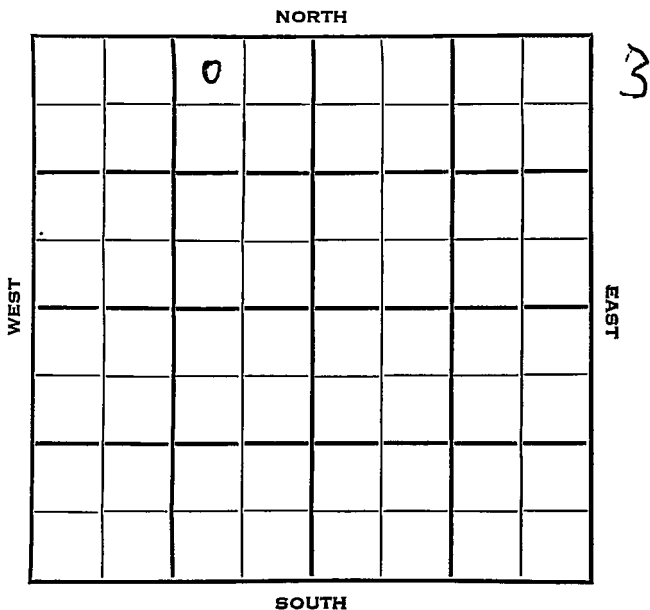

SEC.	TWP.	R.
18	9	21 W ✓

WELL NO.

9 Forgy

FARM

COMPANY

Shields Oil

CONTRACTOR

Barnett Drlg.

Morel Pool


330 Ft. from N. Line

Ft. from S. Line

990 Ft. from E. Line

Ft. from W. Line

NW NE NW

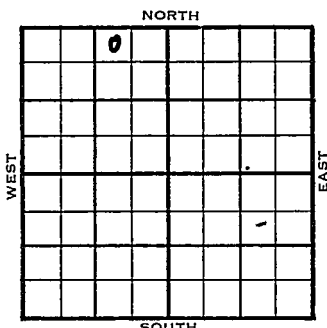

	ELEVATION	REPORT
1953	2321'	
9/30	Spud 9-23-53 8" @ 165 Anhy 1805' Drlg. 2975'	
10/7	Heeb 3392' Lans 3533' DST 3705-37, 20 mins, 190' M B KC 3743' Arb. 3837' RTD 3841' 5" @ 3838'	
10/14	DD 3845' TD FU 500' oil, 1 hrs., S/10 BOPH 3 hrs. FU 2650' oil 12 hrs.	
10/21	NR	
11/4	Spud 9-23-53 Oil well TD 3845 8" @ 165 Anhy 1805' Heeb 3492' Lans. 3533 DST 3705-37 open 20 min rec 190' mud B KC 3743' Arb. 3837 TD 3841 5" @ 3838 DD 3845 FU 500' oil 1 hr. S/10 BOPH 3 hr. FU 2650' oil 12 hr. Comp. 248 BOPD	
COMPLETED		

County Graham State Kansas
 Sec. 18 (Blk.) 9 (Sur.) 21W Map No.
 Operator Shields Oil
 Well No. 9 Farm Forgy
 Elev. Location NW NE NW

		o					

FIRST REPORT

330 Ft. From N Line NW
990 Ft. From E Line Quarter
 SEP 30 1953

1st. Report

Completion

Remarks

Barnett Drlg. - Contr.

Spudding Date 9-23-53

Drlg. Data Morel Pool

8" @ 165 Anhy 1805 drlg. 2975

J. G. McGEHEE

County Graham State Kansas
 Sec. 18 (Blk. 9 (Sur. 21W Map No.
 (Twp.) (Rge.)
 Operator Shields Oil
 Well No. 9 Farm Forgy
 Elev. 2321 Location NW NE NW

	a						

330 Ft. From N Line NW

990 Ft. From E Line Quarter

1st. Report

Completion NOV 4 1953

Remarks Morel Pool
Barnett Drlg. - Contr.

Spudding Date 9-23-53

Drlg. Data Oil well TD 3845

8" @ 165 Anhy 1805 Heeb. 3492

Lans. 3533 DST 3705-37 open 20 min.

Rec. 190' mud B KC 3743 Arb. 3837

TD 3841 5" @ 3838 DD 3845 FU 500' oil

1 hr. S/ 10 boph 3 hr. FU 2650' oil

12 hr. Comp. 248 boph

J. G. McGEHEE