


Section 18 Township 9 Range 21W

Well No. 10 Forgy

Company R. W. Shield

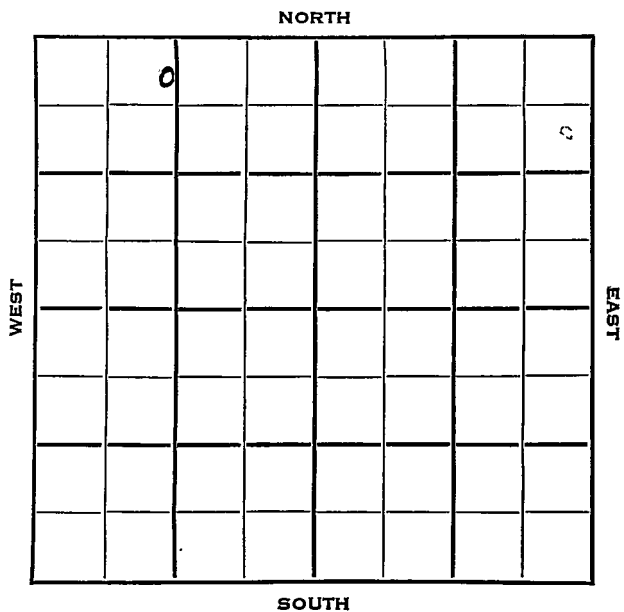

County **Graham** State **Kansas**

Sec. **18** (Blk. **9**) (Sur. **21W**) (Twp.) (Rge.) Map No.

Operator **R. W. Shields**

Well No. **10** Farm **Forge**

Elev. **2321** Location **NE NW NW**

	o					

330 Ft. From **N** Line **NW**

1400 Ft. From **E** Line Quarter

Ist. Report. **FEB 17 1957**

Completion

Remarks **Barnett - Contr.**

Spudding Date

Drlg. Data **Morel Pool**

RUR

County Graham State Kansas
 Sec. 18 (Blk. 9) (Sur. Rge.) 21W Map No. _____
 Operator R. W. Shields
 Well No. 10 Farm Forgy
 Elev. 2321 Location NE NW NW

o					

330 Ft. From N Line NW
1400 Ft. From E Line Quarter
 Ist. Report _____
 Completion MAR 31 1954
 Remarks Mcrel Pool
Barnett - Contr.
 Spudding Date 2-16-54

Drlg. Data Oil well TD 3842
8" @ 163 Heeb. 3488 Lans. 3530
DST 3548-78 open 1 hr. Rec. 1160' SW
1150# DST 3593-3603 open 1 hr. Rec.
215' sw SSO 1260# B KC 3743
Arb. 3839 TD 3842 5" @ 3836 CO to 3840
FU 350' oil 1 hr. @ 0 min. 500 A
S/ 45 boph 4 hr. Comp. 232 bopd