


Section 18 Township 9 Range 21-W

Well No. #2 Seefeld

Company CSO

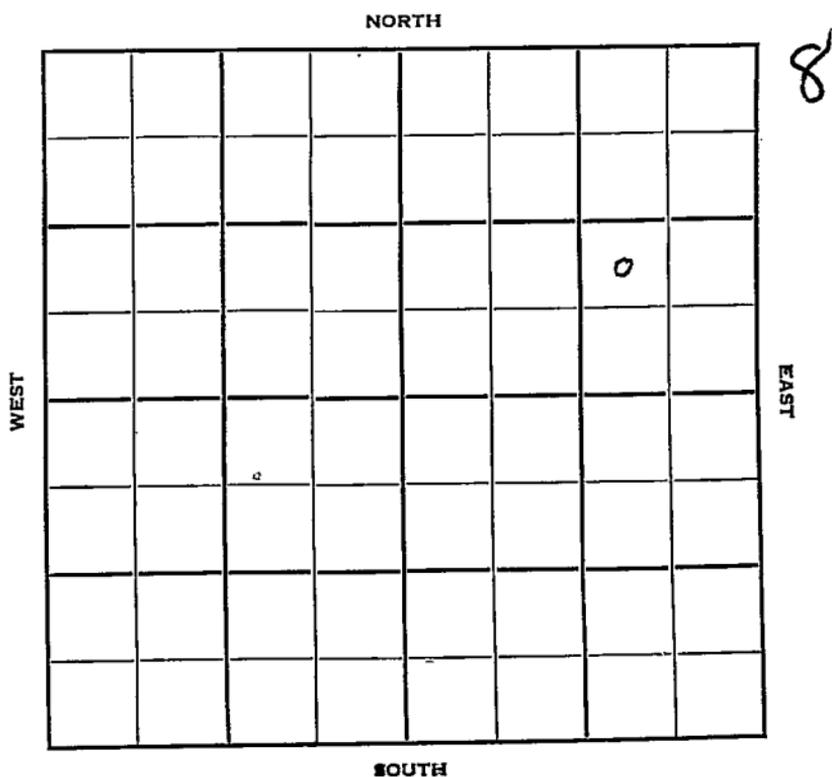

Sec. 18 Twp. 9 R. 21W

Well No. #2 Seefeld Farm

C S O Company

Contractor

Morrell West


Ft. from N. Line

990' Ft. from S. Line

990' Ft. from E. Line

Ft. from W. Line

NW SE NE

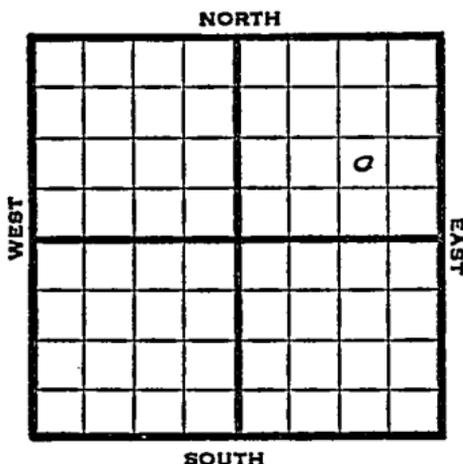

1950

Elev. 2277' REPORT

5/17 Spud 5-14-50
8" @ 240'

6/7 8" @ 240'
Lans. 3486'
Cong 3754'
Simp Sh 3774'
Arb 3778'
5" @ 3780'
1620 BOPD
TD 3793'

COMPLETED

Kansas

Map No. _____ Sec. 18 Twp. 9 R. 21W

Well No. 2 Seefeld

C S O _____ Company

_____ Contractor

NW SE NE

SECTION PLAT

_____ Ft. from N. Line

990 Ft. from S. Line

990 Ft. from E. Line

_____ Ft. from W. Line

			o

FIRST REPORT

Graham

Location _____

Rig up _____

Drilling and Remarks:

Spud 5-14-50

8" @ 240

RECORD

Cased _____ in., _____ ft.

Sand _____

Gas _____

Oil _____

Total Depth _____

PRODUCTION

1st 24 hrs. Nat. _____

1st 24 hrs. after shot _____

Gas _____ Cu. Ft.

Dry Hole _____

Abandoned _____

Date

MAY 17 1950

19

J. E. TYRA

Scout

Kansas

Map No. _____ Sec. 18 Twp. 9 R. 21W

Well No. 2 Seefeld

C S O _____ Company

NW SE NE Contractor

E1.2277

SECTION PLAT

_____ Ft. from N. Line

990 _____ Ft. from S. Line

990 _____ Ft. from E. Line

_____ Ft. from W. Line

COMPLETE			
			o

Graham

Location _____

Rig up _____

Drilling and Remarks:

8" @ 240"
 Lens 3486
 Cong 3754
 Simpsh 3774
 and 3778
 5" @ 3780

RECORD

Cased _____ in., _____ ft.

Sand _____

Gas _____

Oil _____

Total Depth 3793

PRODUCTION

1st 24 hrs. Nat. _____

1st 24 hrs. after shot _____

Gas _____ Cu. Ft.

Dry Hole _____

Abandoned _____

Date 1620 BOPD.

JUN 7 1950 19

J. E. TYRA

Scout