


Section 18 Township 9 Range 21W

Well No. #5 Seefeld

Company Cities Service

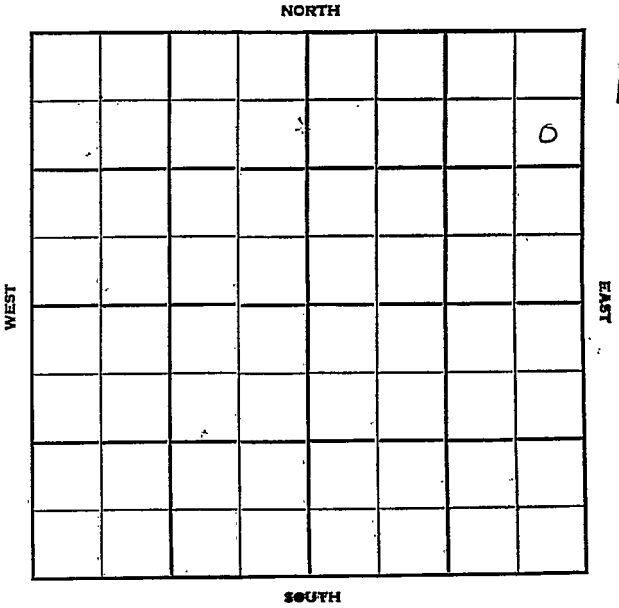

Sec. 18 Twp. 9 R. _____

Well No. #5 Seefeld Farm _____

Cities Service Company _____

Rine Drlg. - Contr. Contractor _____

Morel Pool


990' Ft. from N. Line

_____ Ft. from S. Line

330' Ft. from E. Line

_____ Ft. from W. Line

SE NE NE

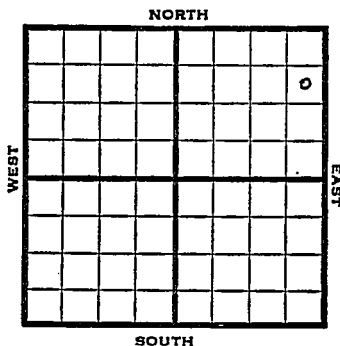

1950

Elev. 2269' REPORT

10/25

Spud 10-18-50
8" @ 240'

11/8

Drlg. 3435'
Spud 10-18-50
Oil Well TD 3784'
8" @ 240' Lans. 3472'
Arb. 3776-78
5" @ 3777
TD 3784'
Comp. 3000 BOPD

COMPLETED

County Graham State Kansas

Sec. 18 (Blk. Twp.) 9 (Sur. Rge.) 21W Map No.

Operator Cities Service

Well No. 5 Farm Seefeld

Elev. 2269 Location SE NE NE

					0
FIRST REPORT					

990 Ft. From N Line NE

330 Ft. From E Line Quarter

1st. Report OCT 25 1950

Completion _____

Remarks _____

Rine Drig. - Contr.

Spudding Date 10-18-50

Drlg. Data Morel Pool

8" @ 240 drlg. 3435

