

32-9-19W

STATE CORPORATION COMMISSION OF KANSAS
OIL & GAS CONSERVATION DIVISIONWELL COMPLETION OR RECOMPLETION FORM
ACO-1 WELL HISTORY

DESCRIPTION OF WELL AND LEASE

Operator: License # 5134
Name Graham-Michaelis Corporation
Address P. O. Box 247
City/State/Zip Wichita, Kansas 67201

Purchaser.....

Operator Contact Person Jack L. Yinger
Phone 316-264-8394

Contractor: License # 5302
Name Red Tiger Drilling Company

Wellsite Geologist Larry Bookless
Phone.....

Designate Type of Completion

☒ New Well ☐ Re-Entry ☐ Workover
☐ Oil ☐ SWD ☐ Temp Abd
☐ Gas ☐ Inj ☐ Delayed Comp.
☒ Dry ☐ Other (Core, Water Supply etc.)

If OWWO: old well info as follows:

Operator.....
Well Name.....
Comp. Date..... Old Total Depth.....

WELL HISTORY

Drilling Method:

☒ Mud Rotary ☐ Air Rotary ☐ Cable

8/12/85 8/18/85 8/19/85
Spud Date Date Reached TD Completion Date
3,759'
Total Depth PBTC

Amount of Surface Pipe Set and Cemented at 296 feet
Multiple Stage Cementing Collar Used? ☐ Yes ☐ No
If yes, show depth set.....feet
If alternate 2 completion, cement circulated
from.....feet depth to.....w/.....Sk cmt

API NO. 15-163-22,720

County...Rooks
SW/4 SE/4 NW/4 32 9S 19W ☐ East
..... Sec..... Twp..... Rge..... ☒ West


3040..... Ft North from Southeast Corner of Section
3630..... Ft West from Southeast Corner of Section
(Note: Locate well in section plat below)

Lease Name...Allphin Well # 1-32

Field Name.....

Producing Formation.....

Elevation: Ground...2196' KB...2201'
Section Plat

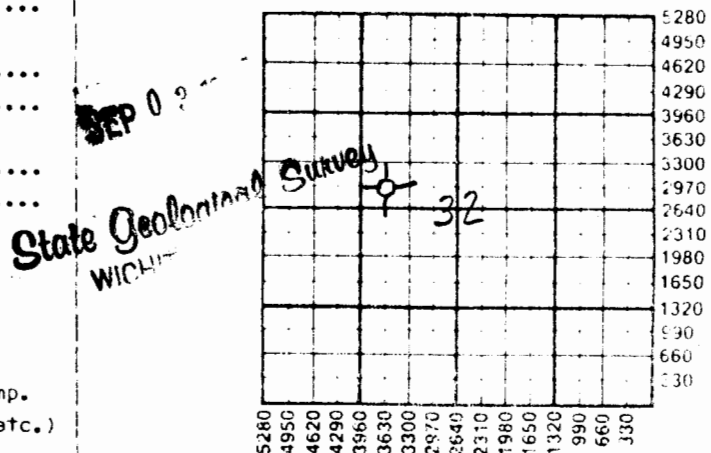

WATER SUPPLY INFORMATION

Disposition of Produced Water: ☐ Disposal
Docket # ☐ Repressuring

Questions on this portion of the ACO-1 call:

Water Resources Board (913) 296-3717

Source of Water:

Division of Water Resources Permit #.....

☐ Groundwater.....Ft North from Southeast Corner
(Well)Ft West from Southeast Corner of
Sec Twp Rge ☐ East ☐ West

☒ Surface Water 900.....Ft North from Southeast Corner
(Stream, pond, etc.) 3500.....Ft West from Southeast Corner
Sec 30 Twp 9S Rge 19 ☐ East ☒ West

☐ Other (explain) Charles Stahl, Zurich, Ks.
(purchased from city, R.4.D. #)

INSTRUCTIONS: This form shall be completed in duplicate and filed with the Kansas Corporation Commission, 200 Colorado Derby Building, Wichita, Kansas 67202, within 90 days after completion or recompletion of any well. Rule 82-3-130 and 82-3-107 apply.

Information on side two of this form will be held confidential for a period of 12 months if requested in writing and submitted with the form. See rule 82-3-107 for confidentiality in excess of 12 months.

One copy of all wireline logs and drillers time log shall be attached with this form. Submit CP-4 form with

61558

SIDE TWO

Operator Name Graham-Michaelis Corporation Lease Name Allphin Well # 1-32

Sec. 32 Twp. 9S Rge. 19W ☐ East ☒ West County Rooks

WELL LOG

INSTRUCTIONS: Show important tops and base of formations penetrated. Detail all cores. Report all drill stem tests giving interval tested, time tool open and closed, flowing and shut-in pressures, whether shut-in pressure reached static level, hydrostatic pressures, bottom hole temperature, fluid recovery, and flow rates if gas to surface during test. Attach extra sheet if more space is needed. Attach copy of log.

Drill Stem Tests Taken ☒ Yes ☐ No
 Samples Sent to Geological Survey ☒ Yes ☐ No
 Cores Taken ☐ Yes ☒ No

Formation Description
☒ Log ☐ Sample

Name	Top	Bottom
Heebner	3416	(-1215)
Lansing	3454	(-1253)
Conglomerate Sand	3726	(-1525)
LTD	3759	(-1558)

DST 3708-59', 60-45-30-90, recovered 30' mud.
 IF 55-55; FF 55-55.
 ISI 883; FSI 926.

SEP 10 1925
 State Geological Survey
 WINNIE BRANCH

CASING RECORD ☒ New ☐ Used							
Report all strings set-conductor, surface, intermediate, production, etc.							
Purpose of String	Size Hole Drilled	Size Casing Set (in O.D.)	Weight Lbs/Ft.	Setting Depth	Type of Cement	#Sacks Used	Type and Percent Additives
Surface	12 1/4"	8 5/8"	23#	303'	Common	180	2% Gel 3%CC
PERFORATION RECORD				Acid, Fracture, Shot, Cement Squeeze Record			
Shots Per Foot	Specify Footage of Each Interval Perforated			(Amount and Kind of Material Used)			Depth
TUBING RECORD				Liner Run ☐ Yes ☐ No			
Size	Set At	Packer at					