


Map No. KANSAS Sec 19 Twp. 9 R. 16^w
 Well No. F-F Westhysyn Farm
Murphree Company

NORTH

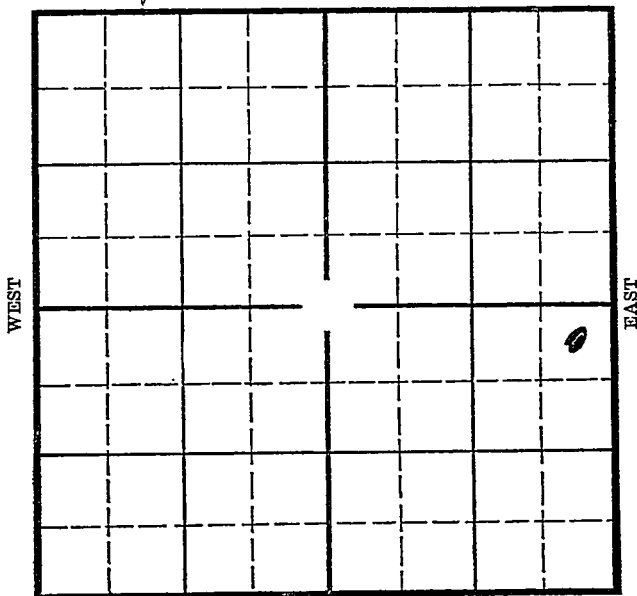

SOUTH

Location _____

Drilling Remarks _____

RECORD

Cased _____ in. _____ ft.
 Sand _____
 Gas _____
 Oil _____
 Total Depth _____

Rig Up _____

Drilling Remarks _____

PRODUCTION

1st 24 hrs. Nat. _____
 1st 24 hrs. after shot _____
 Gas _____ cu. ft. _____
 Dry Hole _____
 Abandoned _____

5/7- 10" @ 2358'. Drlg. 2725'.

5/14- Drlg. 2805-8" @ 2745'.

5/21-Topeka 2915'. Drlg. 2952'.

5/28-Drlg. 3165'.

6/4-K.C. 3185'. H.F.W. 3305'. Drlg.
3312'.

6/11-3335' H.F.W. Drlg.

7/8/36-Sil. 3598'.

H.F.W. 3613-20'.

T.D. 3620'.

D & A

ABANDONED

KANSAS

Map No. *64* Sec. *19* Twp. *9* R. *16 W*

Well No. *1st Westhusin*

Murphy et al Company

Contractor

SECTION PLAT

355 Ft. from N. Line


..... Ft. from S. Line

330 Ft. from E. Line

..... Ft. from W. Line

FIRST REPORT

~~CORRECTION~~

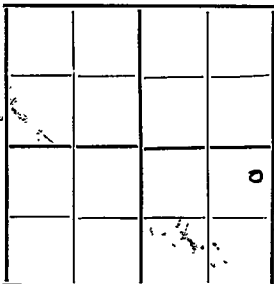

TWIN WELL

Location.....

Rig up.....

Drilling and Remarks:

Spud 25'
S.d. for wat.

RECORD

Cased..... in., ft.

Sand.....

Gas.....

Oil.....

Total Depth.....

PRODUCTION

1st 24 hrs. Nat.....

1st 24 hrs. after shot.....

Gas..... Cu. Ft.

Dry Hole.....

Abandoned.....

Date

12-11-35 192

ORVAL MANNSCHRECK

Scout

Map No. 64 Sec. 19 Twp. 9 R. 16W

Well No. 1 Westhimer

Murphy & Co Company

Contractor

SECTION PLAT

355 Ft. from N. Line

_____ Ft. from S. Line

380 Ft. from E. Line

_____ Ft. from W. Line

			0

ABANDONED

Location _____

Rig up _____

Drilling and Remarks:

Sil 3598.

NFW 3613-20

TYA

RECORD

Cased _____ in., _____ ft.

Sand _____

Gas _____

Oil _____

Total Depth 3620

PRODUCTION

1st 24 hrs. Nat. _____

1st 24 hrs. after shot _____

Gas _____ Cu. Ft.

Dry Hole _____

Abandoned _____

Date

JUL 8 1936

19

S. J. LEWIS

Scout