


Section 19 Township 9 Range 18W

Well No. #1 Hilgers

Company Sinclair Oil & Gas

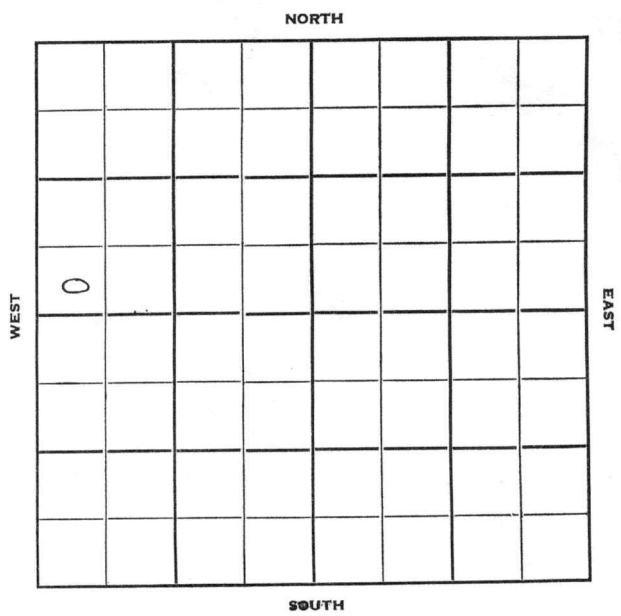

Sec. 19 Twp. 9 R. 18W

Well No. #1 Hilgers Farm

Sinclair Oil & Gas Company

Mayhow Pool


Ft. from N. Line

330' Ft. from S. Line

Ft. from E. Line

330' Ft. from W. Line

SW SW NW

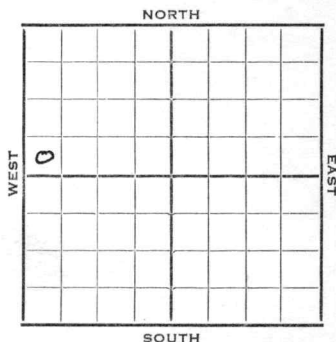

1952 Elev. 2172' REPORT

2/20 Cellar & Pits

3/5 Topeka 3102' SS Oil @ 3410-14'
Heeb 3307' Arb. 3590'
Tor. 3331'

Shut down on account of weather.

3/12 DST 3592-95, 3/4 hr, 10' m plus 10'
HOCM plus 20' clean oil, 970#
TD 3596' 7" @ 3589' CO to 3596'
S/10 gal OCM. 1000 A

3/19 B/5 BOPH for 22 hrs. POP

3/25 "

4/1 POP

4/9 NR

4/23 Spud 2-23-52

Oil Well TD 3569' 10" @ 286

Heeb. 3307 Tor. 3331' Lans. 3348'

SSO 3410-14 Arb. 3590

DST 3592-95 open 3/4 hr. rec. 10' mud

10' HOCM 20' clean oil 7" @ 3589

CO to 3596 S/ 10 gocm 1000 A

S/ 5 BOPH 22 hr.

Comp. 50 BOPD

COMPLETED

J. G. McGEHEE

County **Rooks** State **Kansas**

Sec. 19 (Blk. Twp.) 9 (Sur. Rge.) 18W Map No.

Operator Sinclair Oil & Gas

Well No. 1 Farm Hilgers

Elev.	2172	Location	SW SW NW
-------	------	----------	----------

330 Ft. From S Line NW

330 Ft. From W Line Quarter

1st. Report

Completion APR 23 1952

Remarks	Maynew Pool
---------	-------------

Spudding Date 2-23-52

Drlg. Data Oil well TD 3596

10ⁱⁱ @ 286 Heeb. 3307 Tor. 3331

Lans. 3348 SSO 3410-14 Arb. 3590

DST 3592-95 open 3/4 hr. Rec. 10' mud

10' hocm 20' clean oil 7" @ 3589

CO to 3596 S/ 10 goem 1000 A

S/ 5 boph 22 hr. Comp. 50 bopd

J. G. McGEHEE