

ROOKS

KANSAS

19

9S

18W

SECTION _____ TOWNSHIP _____ RANGE _____

#1 Gilbert

WELL NO. _____

COMPANY Osage Oil & Gas

NORTH

WEST

EAST

				0			

SOUTH

Rooks

KANSAS

SEC.

19

TWP.

9S

R.

18W

WELL NO.

#1 Gilbert

FARM

COMPANY

Osage Oil & Gas

CONTRACTOR

Heathman & Seeligson

Zurich


_____ FT. FROM N. LINE

_____ FT. FROM S. LINE

_____ FT. FROM E. LINE

_____ FT. FROM W. LINE

SW NW SE

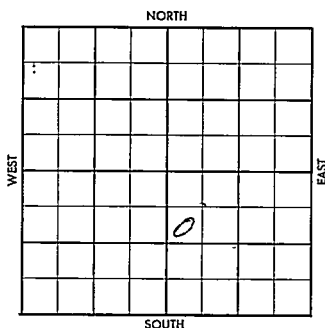

Heathman & Seeligson (F0)

ELEVATION

1956

2175'

REPORT

6-13

Somm. 6-8-56

8" @ 158 w/125

Drlg. 2420

6-20

D & A

Tp. 3119', H. 3329', Tr. 3347',

L. 3369', B.K.C. 3556', Cherty 3619'

TD 3668'

ABANDONED

County Rooks Elev. _____
 Sec. 19 Twp. 9S Rge. 18W
 Company Osage Oil & Gas
 Farm Name Gilbert No. 1

TOPS	DEPTH	LOG	DATUM	Loc. in Sec. _____
Anh. _____				SW NW SE
TP. _____				
H. _____				
Tr. _____				
Dg. _____				
BL. _____				
L. _____				Geol. _____
K.C. _____				Contr. <u>Heathman</u>
B.K.C. _____				& <u>Seeligson</u>
Ce. _____				Pool _____
C. _____				<u>Zurich</u>
M. _____				FIRST REPORT JUN 13 '56
M. _____				
K. _____				
Mz. _____				
Mo. _____				
V. _____				
S. _____				
S. _____				
A. _____				
R. _____				
PE. _____				
G. _____				
T.D. _____				

Date Comm. 6/8/56 Heathman & Seeligson (FO)
8" 158 W/125, D 2420

2007 2 1 AM

2007 2 1 AM

FORM 513 SUNRAY

County Rocks Elev. 2175
 Sec. 19 Twp. 9S Rge. 18W
 Company Geage Oil & Gas
 Farm Name Gilbert No. 1

TOPS	DEPTH	LOG	DATUM	Loc. in Sec.
Anh.				SW NW SE
Tr.	3119			
H.	3329			
Tr.	3347			
Dg.				
BL.				
L.	3369			Geol.
K.C.				Contr. Heathman
B.K.C.	3556			& Seeligson
C. <u>cherty</u>	3619			Pool
M.				Zurich
M.				
K.				
Mz.				
Mo.				
V.				
S.				
S.				
A.				
R.				
Pe.				
G.				
TD.	3668			

ABANDONED
 JUN 20 1956

Date Comm. 6/8/56 Heathman & Seeligson (FO)R¹¹ 158 W/125, D 2420 JUN 20 56

D & A.