

Rooks

FORM 51

KANSAS

O.W.W.O.

Section 19 Township 9 Range 18W

Well No. #1 Gilbert

Company Continental Oil Company

NORTH

							0

WEST

EAST

SOUTH

Sec. 19 Twp. 9 R. 18 W

Well No. # 1 Gilbert Farm \_\_\_\_\_

Continental Oil Company

Garvey Contractor


\_\_\_\_\_ Ft. from N. Line

330 Ft. from S. Line

330 Ft. from E. Line

\_\_\_\_\_ Ft. from W. Line

**SE SE SE**

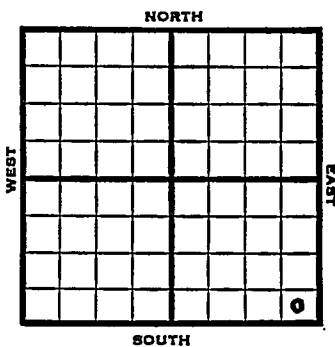

**1953 Elev. 2186' REPORT**

2/25 Spud 2-23-53  
10" @ 207 WOC

3/12 Heeb 3320 Tor 3344 Lans 3360  
Arb. 3615  
DST 3615-23, 1 hr, 60' OCM 560#  
RTD 3623 5" @ 3620 CO

3/19 Testing

3/26 "

4/2 "

4/9 NR

4/16 "

4/22 Spud 2-23-53  
Oil well TD 3628 10" @ 207  
Heeb 3320 Tor 3344 Lans 3360  
Arb. 3615  
DST 3615-23 open 1 hr, rec 60' OCM  
560# TD 3623 5" @ 3620 CO to 3623  
S/1/2 BOPH 4 hr. 500 A S/1 BOPH  
4 hr. 2000 A S/1 1/2 BO 1/2 BWPH 10 hr.  
24/3596-3606 12/3608-12 S/1-1/3 BO  
1/4 BWPH 18 hr. 1000 A S/18 BO 8 1/2 BW  
13 hr. S/28 BO 7 BWPD PB 3615  
500 A S/25 BO 3 BW 3 hr. CO to 3623  
14/3616-20 S/14 BO 1 BW 8 hr.  
DD 3628 S/1 1/2 BO 1/5 BW 8 hr.  
Comp. 36 BOPD 10% wtr.

**COMPLETED**

**OVER**

1955  
6/1

O.W.W.O.

D & A. TD 3628' OTD 3628'  
5" @ 3620 Lans 3365' Arb. 3619  
PB 3570 48/3444-56 1000 A  
DB 3436 40/3414-24 S/36 BW  
6 hr. PB 3390 64/3360-76 1000 A  
S/2 BO 13 BW 6 hr. 2000 A  
S/2 BO 56 BW 9 hr. S/70 BW 10 hr.  
D & A


FIRST REPORT



ABANDONED



County        Rooks State Kansas  
 Sec. 19 (Blk.       ) 9 (Sur.       ) 18W Map No.         
 Operator Continental Oil  
 Well No. 1 Farm Gilbert  
 Elev. 2186 Location SE SE SE

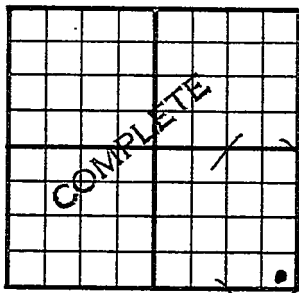

330ft. From S Line SE

330ft. From E Line Quarter

1st. Report

Completion APR 22 1953

Remarks

Garvie - Contr.

Spudding Date 2-23-53

Drlg. Data Oil well TD 3628

10" @ 207 Heeb. 3320 Tor. 3344

Lans. 3360 Arb. 3615 DST 3615-23

open 1 hr. Rec. 60' ocm 560#

TD 3623 5" @ 3620 CO to 3623

S/  $\frac{1}{2}$  boph 4 hr. 500 A S/ 1 boph4 hr. 2000 A S/  $1\frac{1}{2}$  bo  $\frac{1}{2}$  bwph 10 hr.24/ 3596-3606 12/ 3608-12 S/ 1  $1\frac{1}{3}$  bo $\frac{1}{4}$  bwph 18 hr. 1000 A S/ 18 bo  $8\frac{1}{2}$  bw

13 hr. S/ 28 bo 7 bwph PB 3615

500 A S/ 25 bo 3 bw 3 hr. CO to 3623

14/ 3616-20 S/ 14 bo 1 bw 8 hr. DD 3628

S/  $1\frac{1}{2}$  bo  $1\frac{1}{5}$  bw. 8 hr.

Comp. 36 bopd 10% wtr.

J. G. MCGEHEE

