


Section 19 Township 9 Range 18W

Well No. #1 Hibbets Neu

Company H.G. Kaiser & Francis O&G

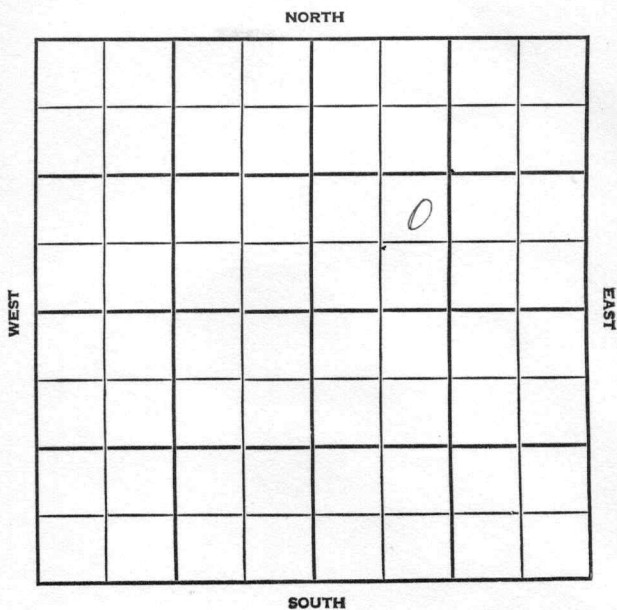

County Rooks Elev. 2156
 Sec. 19 Twp. 9 Rgs. 18W
 Company H.G. Kaiser & Francis O & G
 Farm Name Hibbets Neu No. 1

TOPS	DEPTH	LOG	DATUM	Loc. in Sec.
Anh.				NE SW NE
TP.				
H.				
Tr.				
Dg.				
Bl.				
L.				Geol.
K.C.				
B.K.C.				Contr.
Ce.				<u>K & E</u>
C.				
M.				Pool
M.				<u>Mayhew</u>
K.				
Mz.				
Me.				
V.				
S.				
S.				
A				
R.				
Pe.				
G.				
T.D.				

NOV 14 1956

FIRST REPORT

Date Comm. TITE HOLE
Drlg.

(Faint mirrored text: NOV 5 9 1956)

(Faint text: K. G.)

Co.
Lse.
No.
Sec.
T.
R.

County Rooks Elev. 2156 Co.
 Sec. 19 Twp. 9 Rge. 18W
 Company H.G. Kaiser & Francis O & G
 Farm Name Hibbets Neu No. 1

TOPS	DEPTH	LOG	DATUM	Loc. in Sec.
Anh.				NE SW NE
Tp.	3094			
H.	3305			
Tr.	3324			
Dg.				
Bl.				
L.	3344			Geol.
K.C.				Contr.
B.K.C.	3550			K & E
Ce.				Pool
C.	3583			Mayhew
M.				
M.				
K.				
Mz.				
Me.				
V.				
S.				ABANDONED
S.				
A.	3591			
R.				
PE.				
G.				
TD.	3606			

Date Comm.

TITE HOLE

Drlg. NOV 21 '56 D & A Tite NOV 28 '56

✓ DEC 5 '56 ✓ DEC 12 '56 11-9-56

85/8 209/140 DST 3406-40 1hr
 nec 360' OCM (159% oil) FK 100-180BHP 900 DST 3487-3550 1hr nec
 12' Md BHP 0 DST 3592-971hr nec 5' Md BHP 0/15 DST 3406
 -87 3 hrs nec 666' OCM + 90' OCM2nd BHP 960 DST 3592-3606 1hr
 12' Md BHP 0 D & A