

19

9S

18W

SECTION _____ TOWNSHIP _____ RANGE _____

#3 Hilgers

WELL NO. _____

COMPANY Osage Oil & Gas

NORTH

		0					

WEST

EAST

SOUTH

SEC.	TWP.	R.
19	9S	18W

WELL NO.

3 Hilgers

FARM

COMPANY

Osage Oil & Gas

CONTRACTOR

Heathman & Seeligson

Xurich


_____ FT. FROM N. LINE

_____ FT. FROM S. LINE

_____ FT. FROM E. LINE

_____ FT. FROM W. LINE

NW NE NW

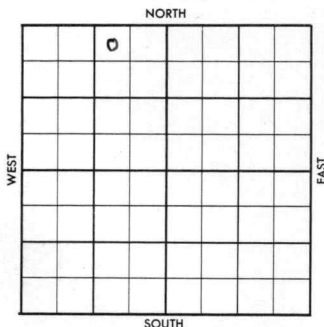

1956	ELEVATION 2148'	REPORT
------	--------------------	--------

6-20 MIRT

7-3

Comm. 6-20-56

8 5/8" @ 1651 w/135

DST 3300-25 op 20 min., rec. 8' mud,
BHP 320#.

D & A

Anh. 1510'; H. 3290'; Tr. 3312';


L. 3331'; C. 3583';

TD 3625';

ABANDONED

County Rooks Elev. _____
 Sec. 19 Twp. 9S Rge. 18W
 Company Osage Oil & Gas
 Farm Name Hilgers No. 3

TOPS	DEPTH	LOG	DATUM	Loc. in Sec.
Anh.				NW NE NW
TP.				
H.				
Tr.				
Dg.				
Bl.				
L.				Geol.
K.C.				Contr. <u>Heathman</u>
B.K.C.				& <u>Seeligson</u>
Ce.				Pool
C.				<u>Eurich</u>
M.				
M.				
K.				
Mz.				
Ma.				
V.				
S.				
S.				
A.				
R.				
Pe.				
G.				
ED.				

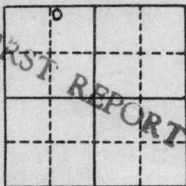Date Comm. MIRT

JUN 20 '56

5201 2 S WUL
 JUN 20 1956

County Rooks Elev. 2148
 Sec. 19 Twp. 2S Rge. 18W
 Company Osage Oil & Gas
 Farm Name Hilgers No. 3

TOPS	DEPTH	LOG	DATUM	Loc. in Sec.
Anh.	1510			NW NE NW
Tr.				
H.	3290			
Tr.	3312			
Dg.				
BL.				
L.	3331			
K.C.				Geol.
B.K.C.				Contr. <u>Heathman</u>
Ce.				& <u>Seeligson</u>
C.	3583			Pool
M.				<u>Zurich</u>
M.				
K.				
Mz.				
Mq.				
V.				
S.				
S.				
A.				
R.				
Pe.				
G.				
T.D.	3625			

Date Comm. MRT JUN 27 '56 ~~JUL 3 1956~~

6-20-56 8 5/8 165/135-Ø 3180

JUL 3 '56 DST 3300-25 20" reg 8'

Md BHP 320

DEA