

Rooks


KANSAS

SECTION 19 TOWNSHIP 9 RANGE 18W

WELL NO. #1 Jelinek

COMPANY Osage Oil & Gas

NORTH

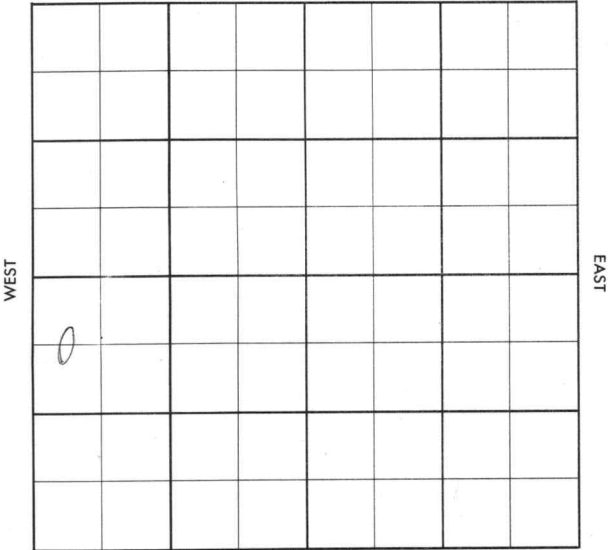

SOUTH

Date Comm.	1-10-57	Sec.
	8 th @ 17 1/2/100 drlg. 2320	

8" @ 17 1/2/100 drlg. 2320

County Rooks Elev. 2189
 Sec. 19 Twp. 9 Rge. 18W
 Company Osage Oil & Gas
 Farm Name Jelinek No. 1

TOPS	DEPTH	LOG	DATUM	Loc. in Sec.
Anh.	1570			C W1 NW SW
Tp.				
H.	3333			
Tr.	3354			
Dg.				
Bl.				
L.	3374			Geol.
K.C.				Contr.
B.K.C.				Prime Drlg.
Ce.				Pool
C.				Mavhow
M.				
M.				
K.				
Mz.				
Mq.				
V.				
S.				
S.				
A.	3625			
R.				
Pe.				
G.				
T.D.	3642			

ABANDONED

JAN 23 '57

Date Comm. 1-10-57

8" @ 171/100 drlg. 2320 JAN 23 '57

OST 3627-32 45" sec 5" Md

BHO

DEA