Rooks

FORM 51


KANSAS

Section 19 Township 9 Range 19W

Well No. #1 Barber

Company K & E Drlg.

5

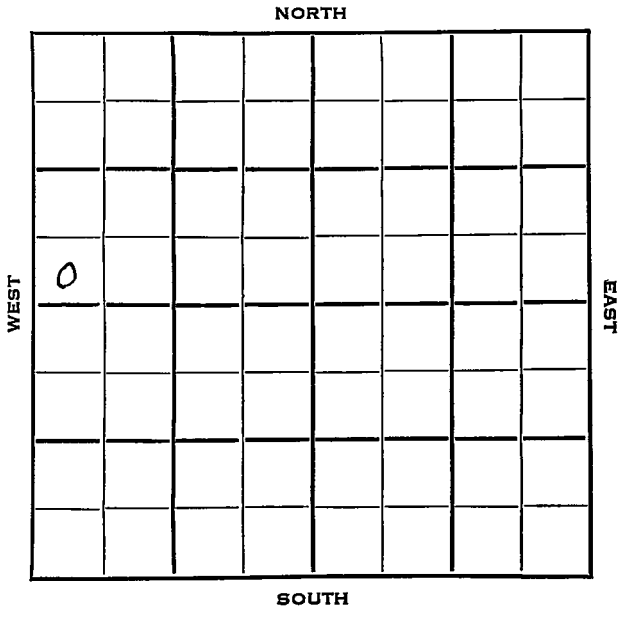

Rooks KANSAS

SEC.	TWP.	R.
19	9	19 W

WELL NO.

I Barber FARM
COMPANY

K & E Drlg.
CONTRACTOR

K & E Drlg.

Wildcat


_____ Ft. from N. Line

330 Ft. from S. Line

_____ Ft. from E. Line

330 Ft. from W. Line

SW SW NW

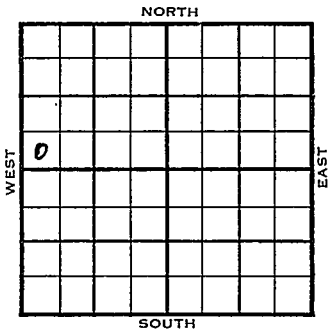

Skelly & Sunray - DHM

	ELEVATION 2109' REPORT
1954	
1/6	Location
1/13	8" @ 185 w/125 Anhy 1542' Drlg. 3082'
1/20	Spud 1-5-54 D & A TD 3065 8" @ 185 Anhy 1542 Top 3074 Heeb 3280 Tor. 3302 Lans 3317 B KC 3526 Cong. 3555 Arb. 3576 DST 3579-85 open 1 hr rec 40' mud 0# TD 3605' D & A

ABANDONED

DX-78

FORM 275 FOR SALE BY KANSAS BLUE PRINT CO.


County Rooks State Kansas

Sec. 19 (Blk. Twp.) 9 (Sur. Rge.) 19W Map No.

Operator K & E Drlg.

Well No. 1 Farm Barber

Elev. Location SW SW NW

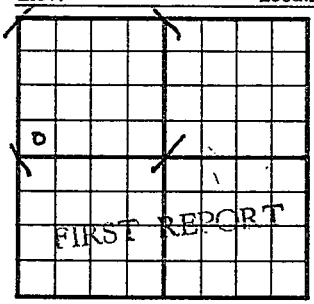

330 Ft. From S Line NW

330 Ft. From W Line Quarter

1st. Report JAN 6 1954

Completion

Remarks Skelly & Sunray - DHM K & E Drlg. - Contr.

Spudding Date

Drlg. Data Wildcat

Location

J. G. McGEHEE

FORM 275 FOR SALE BY KANSAS BLUE PRINT CO.


County Rooks State Kansas

Sec. 19 (Blk. Twp.) 9 (Sur. Rge.) 19W Map No.

Operator K & E Drlg.

Well No. 1 Farm Barber

Elev. 2109 Location SW SW NW

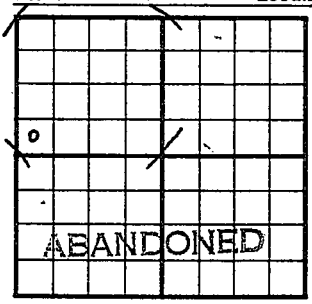

330 Ft. From S Line NW

330 Ft. From W Line Quarter

1st. Report

Completion JAN 20 1954

Remarks Wildcat

K & E Drlg. - Contr.

Spudding Date 1-5-54

Drlg. Data D & A TD 3605

8" @ 185 Anhy 1542 Top. 3074

Heeb. 3280 Tor. 3302 Lans. 3317

B KC 3526 Cong. 3555 Arb. 3576

DST 3579-85 open 1 hr. Rec. 40' mud

0# TD 3605

D & A

J. G. McGEHEE