

Section 19 Township 9 Range 20WWell No. #3 BalthazorCompany Amerada

NORTH

						0	

WEST

EAST

SOUTH

Rooks

KANSAS

Sec. 19 Twp. 9 R. 20W 1

Well No. #3 Balthazor Farm

Amerada Company

Contractor

Gray-Rook

330

Ft. from N. Line


Ft. from S. Line

990

Ft. from E. Line

Ft. from W. Line

NW NE NE

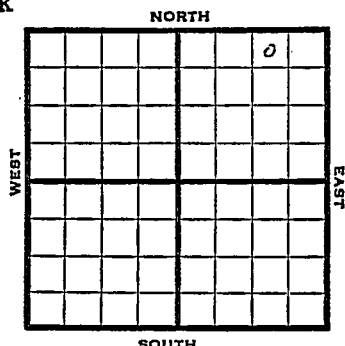

1951

Elev. 2241'

REPORT

10/31

Location

12/5

Spud 11-4-51

Oil Well TD 3791

10" @ 183'

Heeb 3456 Br. li 3477

Ians. 3491

DST 3486-3560 open 2 hr.

Rec. 128' WCM

Simp. 3750 Arb. 3765

TD 3791

DST 3760-91 open 2 hr. rec. 250'

OCM 2700' free oil

7" @ 3767 CO to 3768 FU 2250'

oil 4 hr. CO to 3791 S/ 32 BO

1 hr. Comp. 3000 BOPD

Ind. cap. Echo pot. 12,804 BOPD

COMPLETED



0
FIRST REPORT

990 Ft. From E Line Quarter

Completion

Remarks

Spudding Date

Drlg. Data **Gray - Rook**

Location

J. E. TYRA

County Rooks State KansasSec. 19 (^{Blk.}Twp.) 9 (^{Sur.}Rge.) 20W Map No. _____Operator AmeradaWell No. 3 Farm BalthazorElev. 2241 Location NW NE NE

330 Ft. From N Line NE990 Ft. From E Line Quarter

1st. Report _____

Completion DEC 5 1951Remarks Gra-Rook PoolSpudding Date 11-4-51Drig. Data Oil well TD 379110" @ 183 Heeb. 3456 Br. lime 3477Lans. 3491 DST 3486-3560 open 2 hr.Rec. 128' wcm Simp. 3750 Arb. 3765TD 3791 DST 3760-91 open 2 hr.Rec. 250' ocm 2700' free oil 7 $\frac{1}{2}$ " @ 3767CO to 3768 FU 2250' oil 4 hr. CO to 3791S/32 bo 1 hr. Comp. 3000 bopdInd. cap. Echo pot. 12,804 bopd

J. E. TYRA