

Section 19 Township 9 Range 20W

Well No. 1 Copeland

Company Sinclair-Prairie

Hampton Pool

NORTH

0							

13

WEST

EAST

SOUTH



Sec. 19 Twp. 9 R. 20W

Well No. #1 Copeland Farm

Sinclair-Prairie Company


Hampton Pool

_____ Ft. from N. Line

330' Ft. from S. Line

_____ Ft. from E. Line

330' Ft. from W. Line

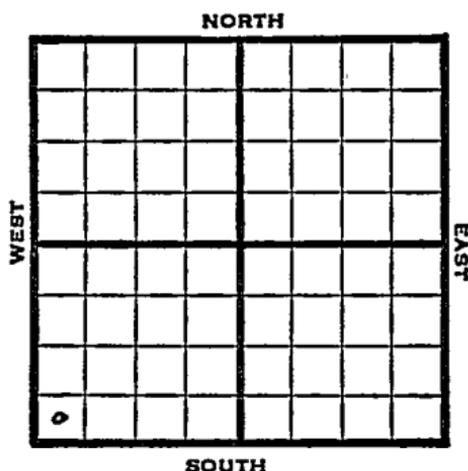

.SW/C

1948	Elev. 2287' REPORT
10/27	Location
11/3	"
11/10	"
11/16	RUR
11/23	Drlg 70'
11/30	Drlg 2695'
12/8	Drlg 3656'
12/15	Lansing 3550'
	Arb. 3838-
	TD 3905
	5" @ 3905'
12/22	50 shots 3841-50
	1000 acid
12/29	"
1949	
1/5	Arb. 3838'
	5" @ 3905'
	Perf.
	2000 acid
	Echo Pot. 3000 oil
	Gr. 270
	TD 3905'
	COMPLETED

Map No. _____ Sec. 19 Twp. 9 R. 20W

Well No. 1 Copeland

Sinclair-Prairie Company

FIRST REPORT

Contractor _____

SW/C

SECTION PLAT

_____ Ft. from N. Line

330 Ft. from S. Line

_____ Ft. from E. Line

330 Ft. from W. Line

Rooks County

Location X

Rig up _____

Drilling and Remarks:

RECORD

Cased 3 in. _____ ft.

Sand _____

Gas _____

Oil _____

Total Depth _____

PRODUCTION

1st 24 hrs. Nat. _____

1st 24 hrs. after shot _____

Gas _____ Cu. Ft.

Dry Hole _____

Abandoned _____

Date

OCT 27 1948

19

S. J. LEWIS

Scout

Kansas

Map No. 65 Sec. 19 Twp. 9 R. 20W

Well No. 1 Copeland

Sinclair-Prairie

Company

COMPLETE

Contractor

SW/C

E12287
SECTION PLAT

_____ Ft. from N. Line

330 Ft. from S. Line

_____ Ft. from E. Line

330 Ft. from W. Line

Rooks County

Location _____

Rig up _____

Drilling and Remarks:

Co #3835
5' 03905
Perf.
2000000
Echo #3000000
27 3/4

RECORD

Cased _____ in., _____ ft.

Sand _____

Gas _____

Oil _____

Total Depth 3905

PRODUCTION

1st 24 hrs. Nat. _____

1st 24 hrs. after shot _____

Gas _____ Cu. Ft.

Dry Hole _____

Abandoned _____

Date

JAN 5 1949 19

S. J. LEWIS

Scout