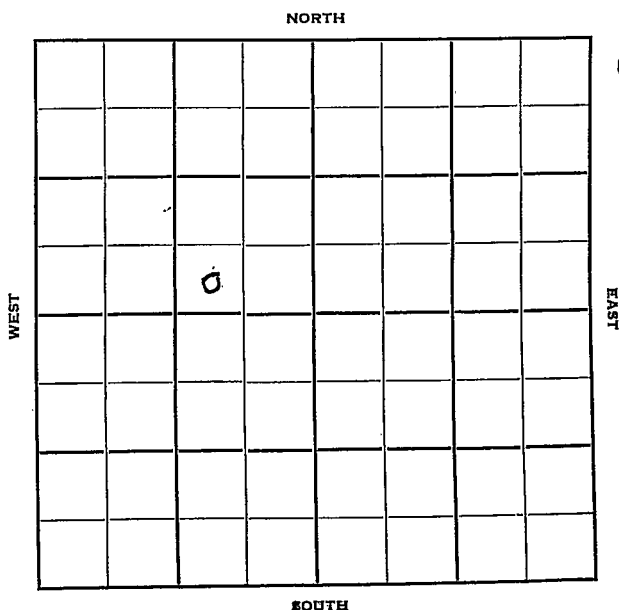


Section 19 Township 9 Range 20WWell No. #6 CopelandCompany Sinclair

6

Rooks **KANSAS**

Sec. 19 Twp. 9 R. 20W

Well No. #6 Copeland Farm ☒

Sinclair Company

Paleo Contractor

 Ft. from N. Line


330' Ft. from S. Line

990' Ft. from E. Line

 Ft. from W. Line

SW SE NW

Oil Well

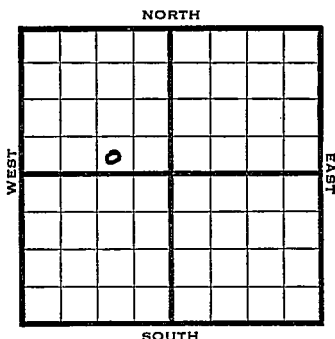

1950 Elev 2282 REPORT

8/23 Spud 8-19-50
10-3/4" @ 280'
Drilg. 2150'

9/13 10 3/4" @ 280
Lans 3542
Simp 3813
TD 3832

Cong 3806
Arb 3824

5 1/2" @ 3824
FU 1000' oil in 1 hr
2600' in 4 hr
S/35 boph 5 hr
Comp 3000 bopd
Completed

COMPLETED

J. E. TYRA

