


Section 19 Township 9 Range 20 W

Well No. # 8 Coepland

Company Sinclair Oil

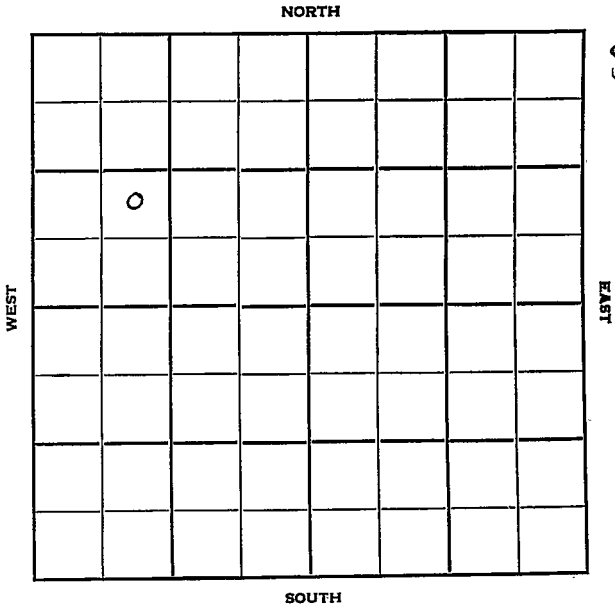

Sec. 19 Twp. 9 R. 20W

Well No. #8 Copeland Farm

Sinclair Oil Company

Murfin Drlg. -Contr. Contractor

Gray Rocks Pool


_____ Ft. from N. Line

990' Ft. from S. Line

_____ Ft. from E. Line

990' Ft. from W. Line

NE SW NW

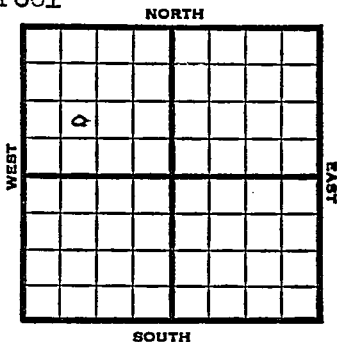

1951 REPORT
Elev. 2244'

4/25

Location

6/13

Spud 5-5-51 Oil well TD 3787½
 10" @ 216 Top 3251' Heeb 3458'
 Tor. 3480' Lans 3499' Cong 3757'
 Simp. 3770' Arb. 3782'
 TD 3785' 7" @ 3782 DD 3785½
 FU 585' oil 15 min. 2500' oil 3 hr.
 1000 A DD 3787½ FU 2800' oil
 1000 A S/8 BOPH 5 hr.
 Comp. draw down pot. 2822 BOPD

COMPLETED

County Rooks State Kansas

Sec. 19 (Blk. Twp.) 9 (Sur. Rge.) 20W Map No.

Operator Sinclair Oil

Well No. 8 Farm Copeland

Elev. 2244 Location NE SW NW

990 Ft. From S Line NW

990 Ft. From W Line Quarter

Ist. Report

Completion JUN 13 1951

Remarks Gray Rocks Pool

Murfin Drlg. - Contr

Spudding Date 5-5-51

Drlg. Data Oil well TD 3787 $\frac{1}{2}$

10" @ 216 Top. 3251 Heeb. 3458

Ter. 3480 Lans. 3499 Cong. 3757

Simp. 3770 Arb. 3782 TD 3785

7" @ 3782 DD 3785 $\frac{1}{2}$ FU 585' oil

15 min. 2500' oil 3 hr. 1000 A

DD 3787 $\frac{1}{2}$ FU 2800' oil 1000 A

S/ 8 boph. - 5 hr.

Comp. draw down pot. 2822 bopd

J. E. TYRA