


Section 19 Township 9 Range 21W

Well No. #2 Pricer

Company Cities Service

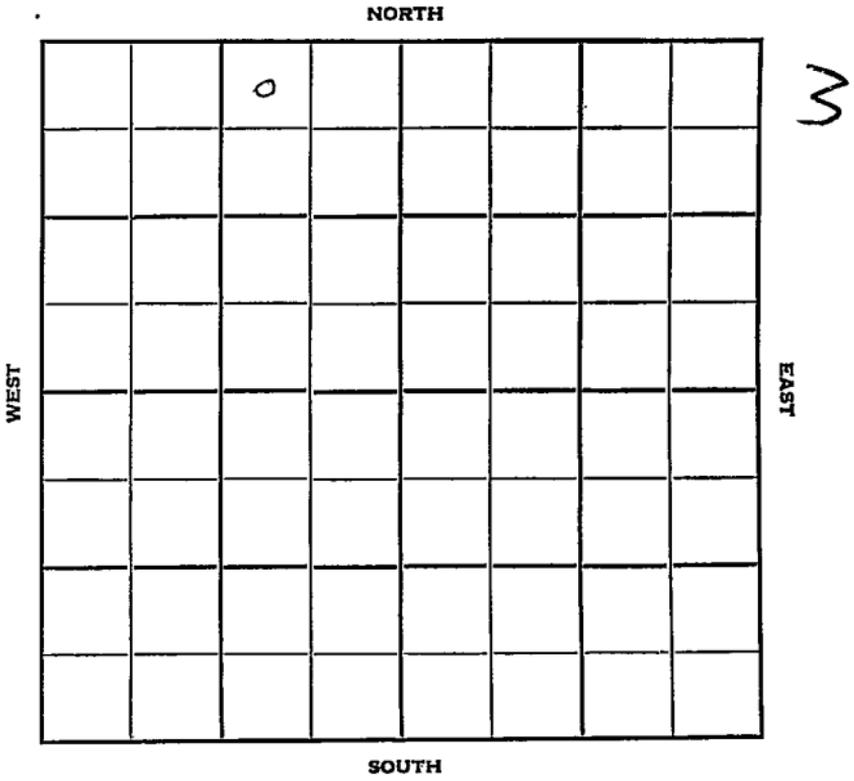

Sec. 19 Twp. 9 R. 21W ✓

Well No. #2 Pricer Farm

Cities Service Company

Rine Drlg.- Contr. Contractor

Morel Pool


330' Ft. from N. Line

\_\_\_\_\_ Ft. from S. Line

990' Ft. from E. Line

\_\_\_\_\_ Ft. from W. Line

NW NE NW

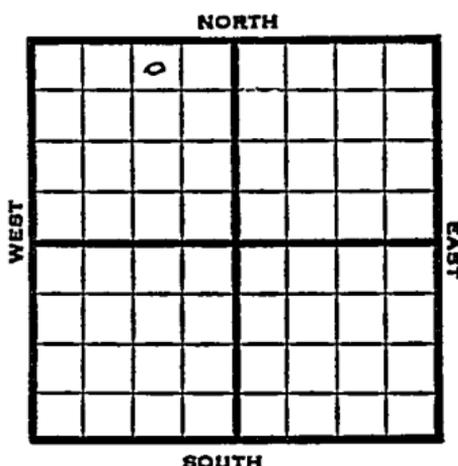

1951 Elev. 2337' REPORT

4/11 Location

5/9 Spud 4-13-51

Oil well TD 3864'

8" @ 240' Heeb 3508', Dodge 3529',

Lans. 3547', Cong. 3821', Simp. 3841',

ReArb. 3856', Arb. 3858',

5" @ 3859', TD 3864'

Comp. draw down pot. 3000 BOPD

**COMPLETED**



County Graham State Kansas

Sec. 19 (Blk.) 9 (Sur.) 21W Map No.

Operator Cities Service

Well No. 2 Farm Pricer

Elev. 2337 Location NW NE NW

	0				

330 Ft. From N Line NW

990 Ft. From E Line Quarter

Ist. Report

Completion MAY 9 1951

Remarks Morel Pool

Rine Drlg. - Contr.

Spudding Date 4-13-51

Drlg. Data Oil well TD 3864

8" @ 240 Heeb. 3508 Dodge 3529

Lans. 3547 Cong. 3821 Simp. 3841

ReArb. 3856 Arb. 3858 5" @ 3859

TD 3864 Comp. draw down pot. 3000 bopd