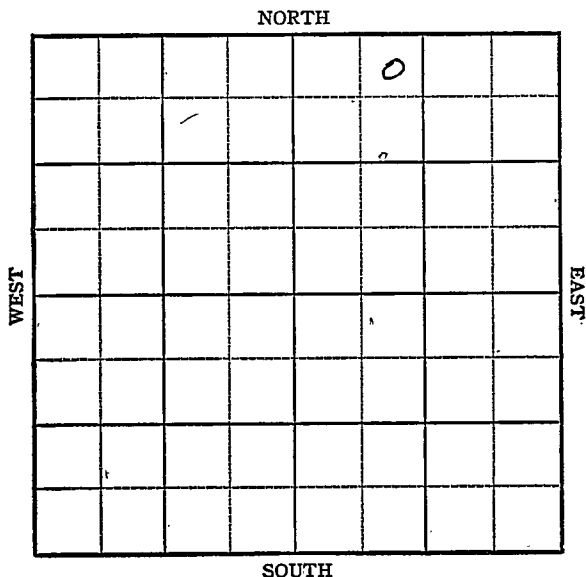


Section 19 Township 9 Range 21WWell No. #1 FuryCompany Peel - Hardman

Graham

KANSAS
21W

Sec. 19 Twp. 9 R. 21W

Well No. #1 Fury Farm

Peel - Hardman Company

Contractor

Morel Pool


330' Ft. from N. Line

_____ Ft. from S. Line

_____ Ft. from E. Line

990' Ft. from W. Line

NE NW NE

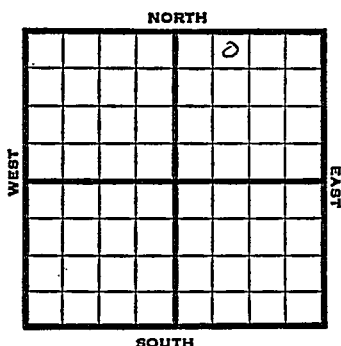

1951 Elev. 2340' REPORT

5/29 Spud 5-26-51
8" @ 157
Drlg. 1350'

7/25 Spud 5-26-51
Oil well TD 3873'
8" @ 157' Heebner 3519'
Lansing 3558' Arbuckle 3864-70'
5½" @ 3868' TD 3879'
DD 3873 8 GOPH 300 A S/4 BOPH
Comp. 151 BOPD

COMPLETED

County Graham State Kansas
 Sec. 19 (Blk. 9) (Sur. 21W) (Twp. 9) Map No. 21W
 Operator Peel - Hardman
 Well No. 1 Farm Fury
 Elev. _____ Location NE NW NE

330 Ft. From N Line NE
990 Ft. From W Line Quarter
 Ist. Report MAY 29 1951
 Completion _____
 Remarks _____
 Spudding Date 5-26-51

Drlg. Data Morel Pool
8" @ 157 drlg. 1350

J. E. TYRA

County Graham State Kansas

Sec. 19 (Blk. Twp.) 9 (Sur. Rge.) 21W Map No.

Operator Peel - Hardman

Well No. 1 Farm Fury

Elev.	2340	Location	NE NW NE
-------	------	----------	----------

330 Ft. From N Line NE

990 Ft. From W Line Quarter

1st. Report

Completion JUL 25 1951

Remarks Morel Pool

Spudding Date 5-26-51

Drig. Data Oil well TD 3873

8" @ 157 Heeb. 3519 Lans. 3558

Arb. 3864-70 5 $\frac{1}{2}$ " @ 3868 TD 3879

DD 3873 8 goph 300 A S/ 4 boph

Comp. 151 bopd