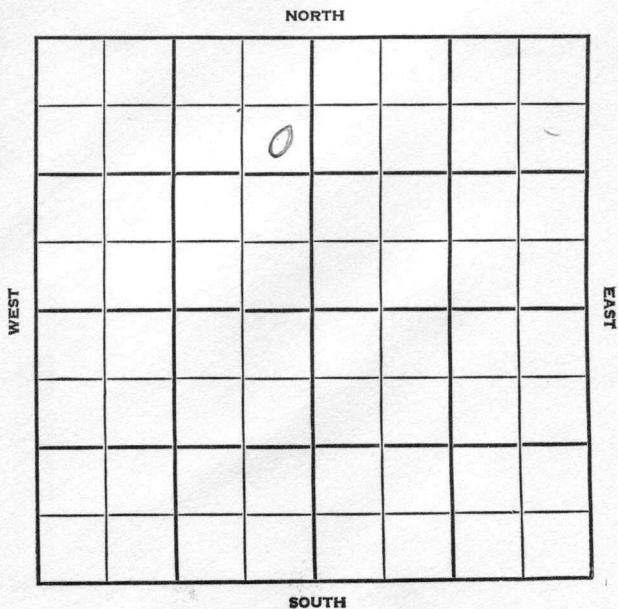


Section 19 Township 9 Range 27WWell No. #1 HoffnerCompany NCRA

County Sheridan Elev. _____
Sec. 19 Twp. 9 Rge. 27W
Company N O R A
FarmName Hoffner No. 1

TOPS	DEPTH	LOG	DATUM	Loc. in Sec.
Anh.				SE NE NW
Tp.				
H.				
Tr.				
Dg.				
BL.				
L.				Geol. _____
N.C.				Contr. _____
B.K.C.				B & B
Ce.				Pool
C.				
M.				
M.				
K.				
Mz.				
Mq.				
V.				
S.				
S.				
A.				
R.				
Pe.				
G.				
T.D.				

Date Comm. 12-1-56
8" @ 294/200 drlg. 1755

33

County Sheridan Elev. 2753
 Sec. 19 Twp. 9 Rge. 27W
 Company N C R A
Haffner No. 1

OPS	DEPTH	LOG	DATUM	Loc. in Sec.
Ann.				SE NE NW
TP.				
H.	3850			
Tr.	3873			
Dg.				
BL.				
L.	3887			Geol.
K.C.				Contr.
B.K.C.				B & B
Ce.				Pool
C.				
M.				
M.				
K.				
Mz.				
Me.				
V.				
S.				
S.				
A.				
R.				
Pe.				
G.				
TD.	4140			



Date Comm. 12-1-56

8" @ 294/200 drlg. 1755 DEC 12 '56

DST 3872-84 1/2 hr 12' Md (550)
 BHP 25/28 DST 3900-20 1/2 hr
 5' Md (550) BHP 30/20 DST
 3924-44 1 1/2 hr 100' SW BHP 890
 120 DST 3947-70 1/2 hr 815' SW BHP
 1300/20 DST 3990-4010 30' 17'
 Md BHP 1340 4010 DEC 19 '56
 DST 4007-35 1/2 hr 50' MW
 BHP 1900 D 8' R