


Section 2 Township 9 Range 15-W

Well No. #1 Nagel

Company Superior Oil

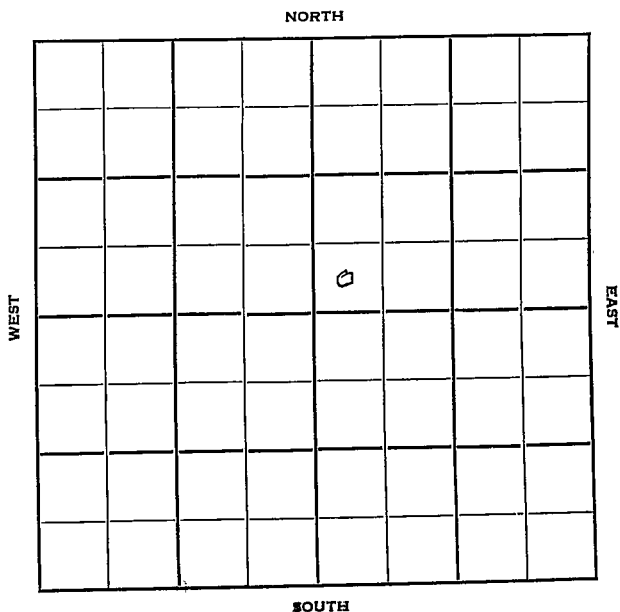

Osborne

KANSAS

Sec. 2 Twp. 9 R. 15W

Well No. #1 Nagel Farm

Superior Oil Company

Contractor


Ft. from N. Line

330' Ft. from S. Line

Ft. from E. Line

330' Ft. from W. Line

SW SW NE

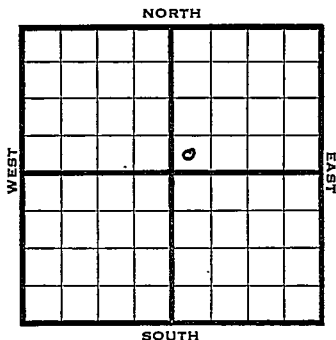

1950

Elev 1922

REPORT

8/9

RUR

9/6

no information

D&A

ABANDONED

County Osborne State KansasSec. 2 (Blk. Twp.) 9 (Sur. Rge.) 15W Map No.Operator Superior OilWell No. 1 Farm NagelElev. Location SW SW NE

FIRST REPORT

0

330 Ft. From S Line NE330 Ft. From W Line Quarter1st. Report AUG 9 1950

Completion


Remarks

Spudding Date

Drlg. Data

R U R

J. E. TYRA

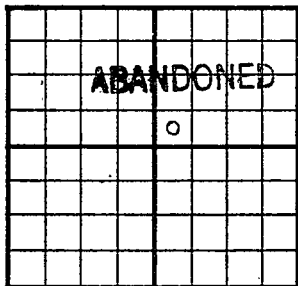County Osborne State KansasSec. 2 (Blk.
Twp.) 9 (Sur.
Rge.) 15W Map No.Operator Superior OilWell No. 1 Farm NagelElev. 1922 Location SW SW NE330 Ft. From S Line NE330 Ft. From W Line Quarter1st. ReportCompletion SEP 6 1950RemarksWildcatSpudding DateDrlg. DataNo information D & A

J. E. TYRA