

KANSAS


Rooks

Form 51-5M-7-40-Palace

Section 2 Township 9 Range 16-W

Well No. #1 Baxter

Company John Washabaugh

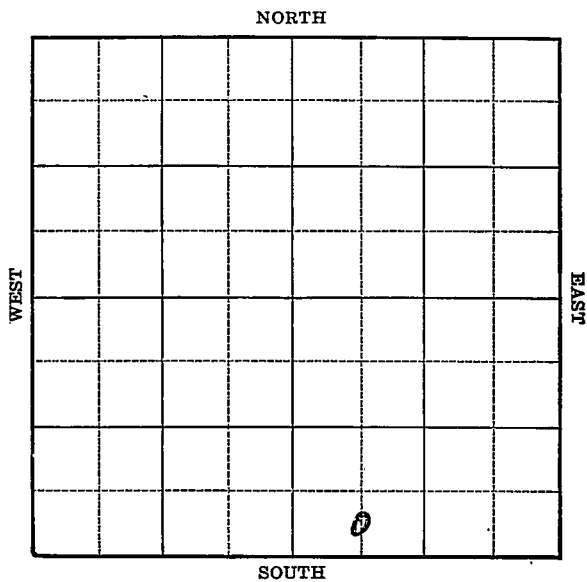


Sec. 2 Twp. 9 R. 16-WWell No. #1 Baxter FarmJohn Washabaugh Company

(Laton)

 Ft. from N. Line330 Ft. from S. Line Ft. from E. Line660 Ft. from W. Line

Elev. 2060

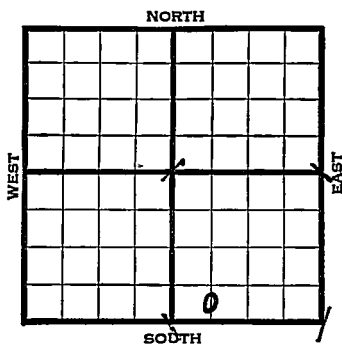

1940	REPORT
9/11	Cable rig.
9/19	Rigging up.
9/26	" "
10/3	" "
10/10	" "
10/17	" "
10/24	655' fsg. bailer.
10/31	12" - 884' Drlg. 990'
11/6	10" - 1090' Drlg. 1275'
11/14	SD storm.
11/21	Anhy 1360' 10" - 1360'
	Drlg. 2355'
11/27	8" - 2375' Drlg. 2425'
12/5	Fsg. 2605'
12/12	7" - 2625' C.O.
12/19	Shut down.
12/26	7" - 2900' Drlg. 2950'
1941	
1/2	SD 2950'
1/9	K.C. 3215-28' T.D. SSO
	7" - 3215' WOC.

OVER

1941

1/16

TD 3228'

7" - 3215'

Shut down.

1/23

K.C. 3206' (Corrected)

7" - 3206' T.D. 3220'

3000 acid. No Help.

Drilg. 3248'

1/30

T.D. 3265' 2500' oil.

2/6

" " " "

2/13

4000 acid. WOA.

2/19

Lans. 3206'

7" - 3206'

T.D. 3265'

8000 acid.

Depthograph potential 2835 bbls.

COMPLETED

Map No. 64 Sec. 2 Twp. 9 R. 16WWell No. 1 BaxterJohn Washabaugh

Company

Contractor

FIRST REPORT

C S L SW SE

Ft. from N. Line


330 Ft. from S. Line

Ft. from E. Line

660 Ft. from W. Line

LATON POOL

SECTION PLAT

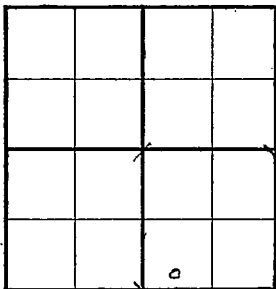

Location _____

Rig up _____

Drilling and Remarks:

Cable Rig

RECORD

Cased _____ in., _____ ft.

Sand _____

Gas _____

Oil _____

Total Depth _____

PRODUCTION

1st 24 hrs. Nat. _____

1st 24 hrs. after shot _____

Gas _____ Cu. Ft.

Dry Hole _____

Abandoned _____

Date

SEP 11 1940 19S. J. LEWIS Scout

Map No. 64 Sec. 2 Twp. 9 R. 16WWell No. 1 BaxterJohn Washabaugh

Company

Contractor

COMPLETED

C S L SW SE

 Ft. from N. Line330 Ft. from S. Line Ft. from E. Line660 Ft. from W. Line

LATON POOL

SECTION PLAT

Location Rig up

Drilling and Remarks:

*Loss 8206.**7" C 3206**8000 acid**Depth 2835***RECORD**Cased in., ft.Sand Gas Oil Total Depth 3265**PRODUCTION**1st 24 hrs. Nat. 1st 24 hrs. after shot Gas Cu. Ft.Dry Hole Abandoned

Date

FEB 19 1941 19

S. J. LEWIS Scout