

KANSAS


FORM 51 5M 4-41 PETROL

Rooks

Section 2 Township 9 Range 16-W

Well No. #2 Baxter "C"

Company Helmerich & Payne

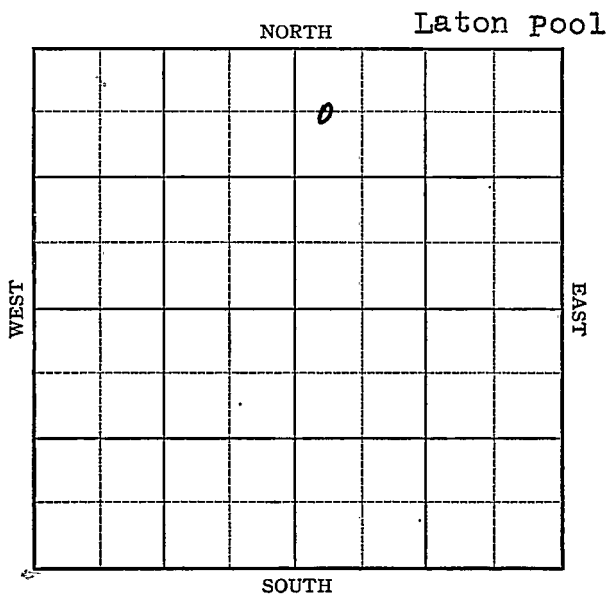

Sec. 2 Twp. 9 R. 16-W

Well No. #2 Baxter "C" Farm

Helmerich & Payne Company

(Laton)


660 Ft. from N. Line

_____ Ft. from S. Line

_____ Ft. from E. Line

330 Ft. from W. Line

Elev. 2036

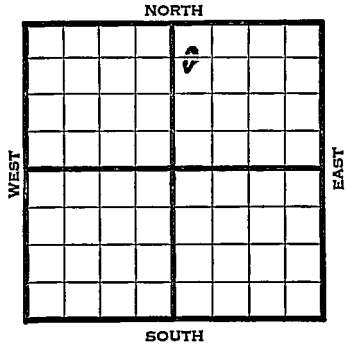

1941	REPORT
5/27	Rotary.
6/5	8" - 100' Lans. 3183'
	T.D. 3224' Run 5".
6/12	" " "
6/18	Lans. 3183'
	5" - 3221'
	T.D. 3265'
	500 acid. Water.
	ABANDONED

Map No. 64 Sec. 2 Twp. 9 R. 16WWell No. 2 Baxter "C"Helmerich & Payne CompanyFIRST REPORT Contractor

C W L NW NE

660 Ft. from N. Line

_____ Ft. from S. Line

_____ Ft. from E. Line

330 Ft. from W. Line

SECTION PLAT

		o	

LATON POOL

Location _____

Rig up _____

Drilling and Remarks:

Rotary

RECORD

Cased _____ in., _____ ft.

Sand _____

Gas _____

Oil _____

Total Depth _____

PRODUCTION

1st 24 hrs. Nat. _____

1st 24 hrs. after shot _____

Gas _____ Cu. Ft.

Dry Hole _____

Abandoned _____

Date

MAY 27 1941S. J. LEWIS

Scout

Map No. 64 Sec. 2 Twp. 9 R. 16WWell No. 2 Baxter "C"Helmerich & Payne Company

Contractor

ABANDONED

C W L NW NE

SECTION PLAT

660 Ft. from N. Line

_____ Ft. from S. Line

_____ Ft. from E. Line

330 Ft. from W. Line

		0	

LATON POOL

Location _____

Rig up _____

Drilling and Remarks:

Lans 3183
5" @ 8221
5000 gal
Water.

RECORD

Cased _____ in., _____ ft.

Sand _____

Gas _____

Oil _____

Total Depth 8225

PRODUCTION

1st 24 hrs. Nat. _____

1st 24 hrs. after shot _____

Gas _____ Cu. Ft.

Dry Hole _____

Abandoned _____

Date

JUN 18 1941₁₉S. J. LEWIS

Scout