

KANSAS

FORM 51 5M PETROL


Rooks

Section 2 Township 9 Range 19W

Well No. #3 D. Barry "B"

12

Company Continental

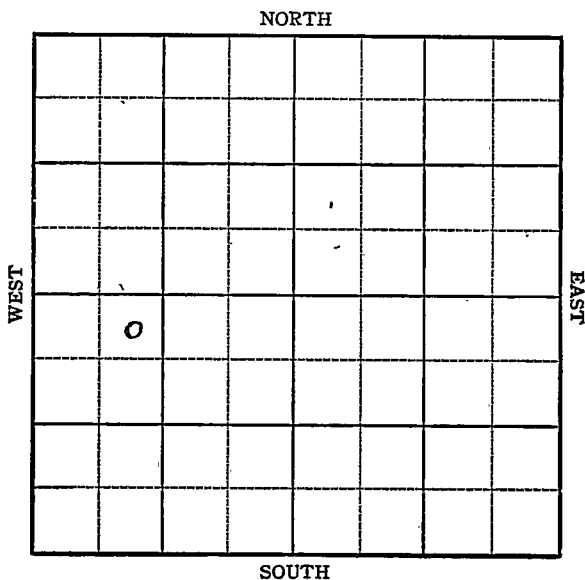

Sec. 2 Twp. 9 R. 19-W

Well No. #3 D. Barry "B" Farm

Continental Company


NE NW SW

330 Ft. from N. Line

_____ Ft. from S. Line

_____ Ft. from E. Line

990 Ft. from W. Line

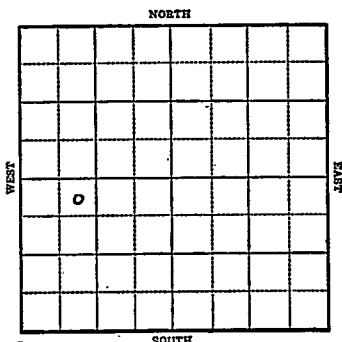

4/25. 2010

1944

R E P O R T

1-26 Derrick

2/8 10" @ 241
Drlg. 2530'

2/15 Drlg. 3335

2/23 Arb 3427-29 TD
6" @ 3428
Rust

3/8 Drlg. 3438-3700' oil

3/16 TD 3443
1000 acid
Depth Pot. 3000

3/22 Arb. 3427
6" @ 3428
1000 acid
Depth Pot. 3000
TD 3443
30.0 Gravity

COMPLETED

Map No. 65 Sec. 2 Twp. 9 R. 19WWell No. 3 D. Barry "B"Continental Company

FIRST REPORT Contractor

NE NW SW

330 Ft. from N. Line

_____ Ft. from S. Line

_____ Ft. from E. Line

990 Ft. from W. Line

SECTION PLAT

o			

Barry Pool

Location _____

Rig up _____

Drilling and Remarks:

Derrick

RECORD

Cased _____ in., _____ ft.

Sand _____

Gas _____

Oil _____

Total Depth _____

PRODUCTION

1st 24 hrs. Nat. _____

1st 24 hrs. after shot _____

Gas _____ Cu. Ft.

Dry Hole _____

Abandoned _____

Date

JAN 26 1944 19S. J. LEWIS Scout

KANSAS

Map No. 67 Sec. 2 Twp. 9 R. 19W

Well No. 3 D. Barry "B"

Continental Company

COMPLETED Contractor

NE NW SW

SECTION PLAT

330 Ft. from N. Line

_____ Ft. from S. Line

_____ Ft. from E. Line

990 Ft. from W. Line

o			

Barry Pool

RECORD

Location _____

Cased _____ in., _____ ft.

Rig up _____

Sand _____

Drilling and Remarks:

Gas _____

Oil _____

Total Depth 3443

See 3427

6" @ 3428

1000 @ acid

Depth to 3000

3000

PRODUCTION

1st 24 hrs. Nat. _____

1st 24 hrs. after shot _____

Gas _____ Cu. Ft.

Dry Hole _____

Abandoned _____

Date

MAR 22 1944

19

S. J. LEWIS

Scout