

# KANSAS

FORM 51 5M 1-42 PETROL


## Rooks

Section 2 Township 9 Range 19-W

Well No. #2 Dan Barry "A"

Company Continental

*15*

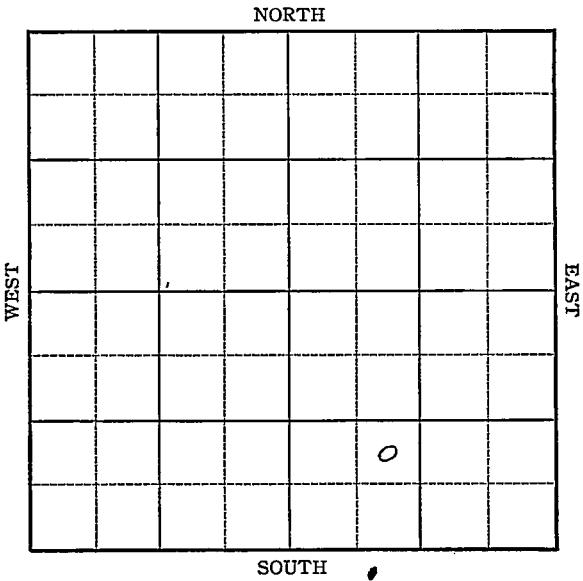

KANSAS

Rooks

Sec. 2 Twp. 9 R. 19-W

Well No. #2 Dan Barry "A" Farm

Continental Company


Barry

           Ft. from N. Line

990 Ft. from S. Line

           Ft. from E. Line

990 Ft. from W. Line

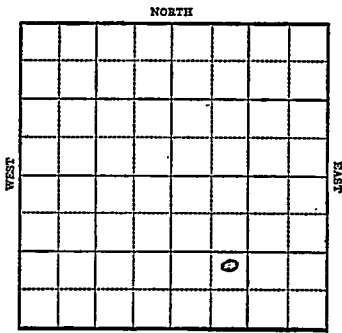

*Elev. 2015*

1943

R E P O R T

6/30

Derrick

7/7

"

7/15

10" @ 242'  
Drlg. 3445'

7/21

Arb 3433-45 T.D.  
6" @ 3435 Rust

7/28

T.D. 3451-2800' oil

8/4

Arb. 3433  
6" @ 3435'  
T.D. 3451'  
Echo Pot 116,000  
Max 3000  
Gravity 29

**COMPLETED**



Rooks

KANSAS  
Map No. 65 Sec. 2 Twp. 9 R. 19WWell No. 2 Dan Barry "A"Continental Company**COMPLETED** Contractor

NE SW SE

## SECTION PLAT


\_\_\_\_\_ Ft. from N. Line

990 Ft. from S. Line

\_\_\_\_\_ Ft. from E. Line

990 Ft. from W. Line

## BARRY POOL

Location \_\_\_\_\_

Rig up \_\_\_\_\_

Drilling and Remarks:

*Core 2433*  
*6" 2435*  
*Echd 24116000*  
*Map 3000*

*29° 4'*

## RECORD

Cased \_\_\_\_\_ in., \_\_\_\_\_ ft.

Sand \_\_\_\_\_

Gas \_\_\_\_\_

Oil \_\_\_\_\_

Total Depth 3451

## PRODUCTION

1st 24 hrs. Nat. \_\_\_\_\_

1st 24 hrs. after shot \_\_\_\_\_

Gas \_\_\_\_\_ Cu. Ft.

Dry Hole \_\_\_\_\_

Abandoned \_\_\_\_\_

Date

AUG 4 1943 19S. J. LEWIS Scout