

# KANSAS

FORM 51 5M 1-42 PETROL


## Rocks

Section 2 Township 9 Range 19 W

Well No. #4 D. Barry "A"

9

Company Continental Oil

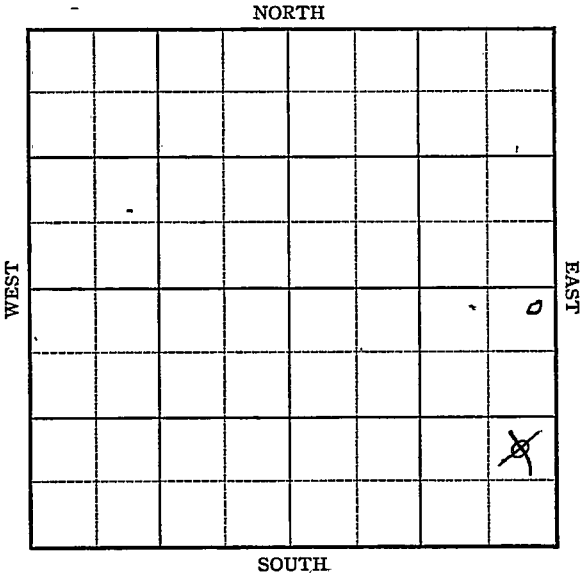


Sec. 2 Twp. 9 R. 19 W

Well No. #4 D. Barry "A" Farm

Continental Company

330 Ft. from N. Line  
         Ft. from S. Line  
330 Ft. from E. Line  
         Ft. from W. Line

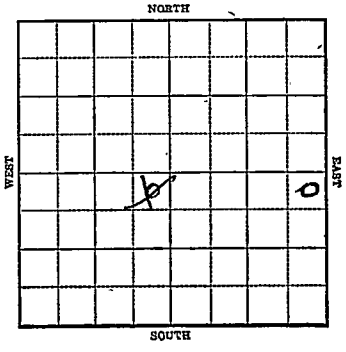

1943

R E P O R T

11/24  
12/1  
12/ 8  
12-15

Location.  
10" @ 241' WOC  
Drlg 3095'  
"

12/22

Arb 3434  
6" @ 3435  
TD 3450-2600' oil

12-29

TD 3450'  
Arb. 3434'  
6" at 3435'  
1000 acid  
Depth Pot. 2911'  
Gravity 29.0

COMPLETED

KANSAS

Map No. 6 Sec. 2 Twp. 9 R. 19W

Well No. 4 D. Barry "A"

Continental Company

FIRST REPORT Contractor

NE SE

SECTION PLAT

330 Ft. from N. Line

			o

\_\_\_\_\_ Ft. from S. Line

330 Ft. from E. Line

\_\_\_\_\_ Ft. from W. Line

Barry Pool

Location X

RECORD

Rig up \_\_\_\_\_

Cased \_\_\_\_\_ in., \_\_\_\_\_ ft.

Drilling and Remarks: \_\_\_\_\_

Sand \_\_\_\_\_

Gas \_\_\_\_\_

Oil \_\_\_\_\_

Total Depth \_\_\_\_\_

PRODUCTION

1st 24 hrs. Nat. \_\_\_\_\_

1st 24 hrs. after shot \_\_\_\_\_

Gas \_\_\_\_\_ Cu. Ft.

Dry Hole \_\_\_\_\_

Abandoned \_\_\_\_\_

Date

NOV 24 1943 19

S. J. LEWIS Scout

KANSAS

Map No. 63 Sec. 2 Twp. 9 R. 19W

Well No. 4 D. Barry "A"

Continental Company

COMPLETED Contractor

NE SE

SECTION PLAT

330 Ft. from N. Line

\_\_\_\_\_ Ft. from S. Line

330 Ft. from E. Line

\_\_\_\_\_ Ft. from W. Line

			o

Barry Pool

Location \_\_\_\_\_

Rig up \_\_\_\_\_

Drilling and Remarks:

*Core 3434*  
*6" core 3435.*  
*1000 acid*  
*Sept 14 1943 2911*  
*29° 9'*

RECORD

Cased \_\_\_\_\_ in., \_\_\_\_\_ ft.

Sand \_\_\_\_\_

Gas \_\_\_\_\_

Oil \_\_\_\_\_

Total Depth 3450

PRODUCTION

1st 24 hrs. Nat. \_\_\_\_\_

1st 24 hrs. after shot \_\_\_\_\_

Gas \_\_\_\_\_ Cu. Ft.

Dry Hole \_\_\_\_\_

Abandoned \_\_\_\_\_

Date

DEC. 2 9 1943 19

S. J. LEWIS Scout