

Rooks County

Barry Pool


FORM 51 IOM 12-46 PETROL

KANSAS

Section 2 Township 9 Range 19W

Well No. 6 Barry "A"

Company Continental 10

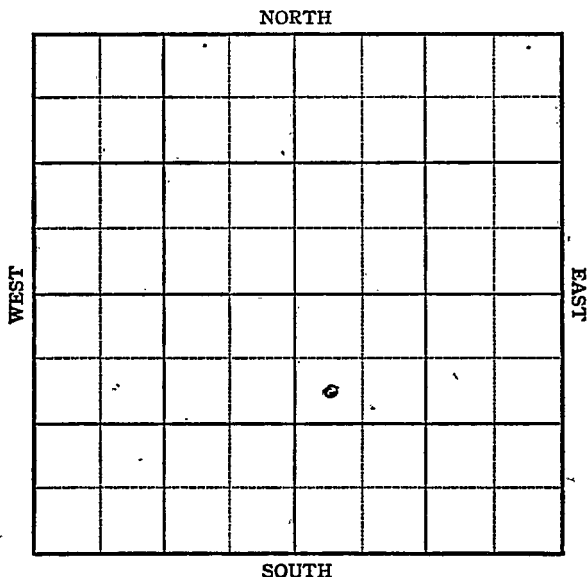

KANSAS

Rooks ✓


Sec. 2 Twp. 9 R. 19-NWell No. #6 Barry "A" FarmContinental Company
Barry Pool

990 Ft. from N. Line

Ft. from S. Line

Ft. from E. Line

330 Ft. from W. Line

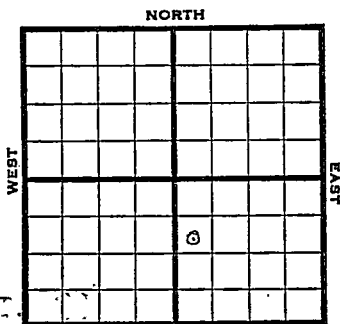SW NW SE * Elev. 2000' SOUTH

1947

REPORT

3/5 Location.

3/11 Derrick

3/18 Derrick

3/25 R UR

4/2 10" @ 240'
Drlg 2225'4/9 Lans 3148
Arb 3417 -21
TD 3421'
8" @ 3418'
RUST4/15 TD 3428'
Swb. 80 bbls. oil in 1 hr.4/23 Arb 3417
6" @ 3418
Echo Pot 3000
Grav. 27
TD 3428'**COMPLETED**

KANSAS

Barry Pool

Kansas

Map No. 65 Sec. 2 Twp. 9 R. 19WWell No. 6 Barry "A"Continental

Company

FIRST REPORT

Contractor

SW NW SE

SECTION PLAT

		o	

990 Ft. from N. Line Ft. from S. Line Ft. from E. Line330 Ft. from W. LineRooks CountyLocation XRig up

Drilling and Remarks:

RECORD

Cased in., ft.Sand Gas Oil Total Depth

PRODUCTION

1st 24 hrs. Nat. 1st 24 hrs. after shot Gas Cu. Ft.Dry Hole Abandoned

Date

MAR 5 1947 19S. J. LEWIS

Scout

Map No. K65 ^{Kansas} Sec. 2 Twp. 9 R. 19W

Well No. 6 Barry "A"

Continental Company

COMPLETE Contractor

SW NW SE


E1,2000
SECTION PLAT

990 Ft. from N. Line

 Ft. from S. Line

 Ft. from E. Line

330 Ft. from W. Line

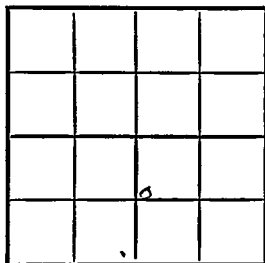

Rooks County

Location

Rig up

Drilling and Remarks:

See 83417

6" @ 8418

E1,2000

270 ft

RECORD

Cased in., ft.

Sand

Gas

Oil

Total Depth 8428

PRODUCTION

1st 24 hrs. Nat.

1st 24 hrs. after shot

Gas Cu. Ft.

Dry Hole

Abandoned

Date

APR 23 1947 19

S. J. LEWIS Scout