


Section 2 Township 9 Range 19W

Well No. 7 Barry "A"

Company Continental 16

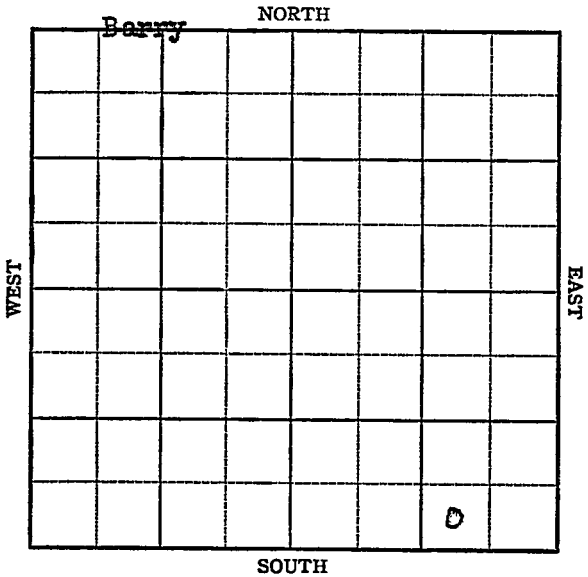

KANSAS

Rooks.

Sec. 2 Twp. 9 R. 19W

Well No. #7 Barry "A" Farm

Continental Company


Barry Pool
Ft. from N. Line

330 Ft. from S. Line

990 Ft. from E. Line

 Ft. from W. Line

SW SE SE

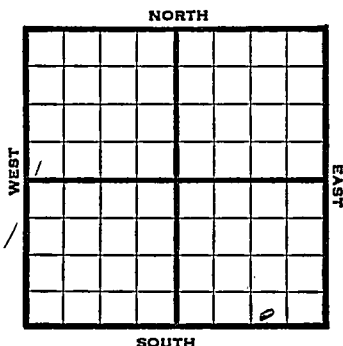

1947 Elev. 2019' REPORT

9/10 Location

9/17 10" @ 200'
Drlg. 2380'

9/24 Arbuckle 3442'
TD 3448'
7" @ 3443'
RUST

10/1 Lansing 3186'
TD 3451' - 500 acid
Swab 50 bbls. oil / 20 W PH 2 hrs.

10/8 PB 3445'

10/15 "

10/22 Swb 100 bbls oil & 7½ W in 7 hrs..

11/5 Arbuckle 3442'
7" @ 3443'
PB 3445'
500 Acid
Pump 25 oil & 10% W Pot.
Gr. 270
Total Depth 3451'
COMPLETED

Kansas

Map No. _____ Sec. 2 Twp. 9 R. 19WWell No. 7 Barry "A"

_____ Continental _____ Company

FIRST REPORT

_____ Contractor

SW SE SE

SECTION PLAT

_____ Ft. from N. Line

330 Ft. from S. Line990 Ft. from E. Line

_____ Ft. from W. Line

		1	0

Rooks County

Location X

Rig up _____

Drilling and Remarks:

RECORD

Cased _____ in. _____ ft.

Sand _____

Gas _____

Oil _____

Total Depth _____

PRODUCTION

1st 24 hrs. Nat. _____

1st 24 hrs. after shot _____

Gas _____ Cu. Ft.

Dry Hole _____

Abandoned _____

Date

SEP 10 1947 19 S. J. LEWIS Scout

Map No. 65 Kansas Sec. 2 Twp. 9 R. 19W

Well No. 7 Barry "A"

Continental Company

COMPLETE Contractor

SW SE SE


E1.2018
SECTION PLAT

 Ft. from N. Line

330 Ft. from S. Line

990 Ft. from E. Line

 Ft. from W. Line

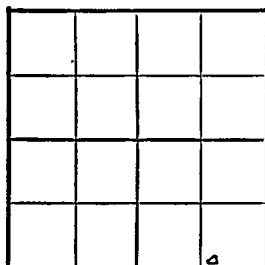

Rooks County

Location

Rig up

Drilling and Remarks:

Cr 83442

9" @ 34.42

PB 3445

500 @ acid

Run 25 oil + 10%

W.P.D.

27 2/3

RECORD

Cased in., ft.

Sand

Gas

Oil

Total Depth 3451

PRODUCTION

1st 24 hrs. Nat.

1st 24 hrs. after shot

Gas Cu. Ft.

Dry Hole

Abandoned

Date

NOV 5 1947 19

S. J. LEWIS Scout