


Section 2 Township 9 Range 19W

Well No. 8 Dan Barry "A"

Company Continental 15

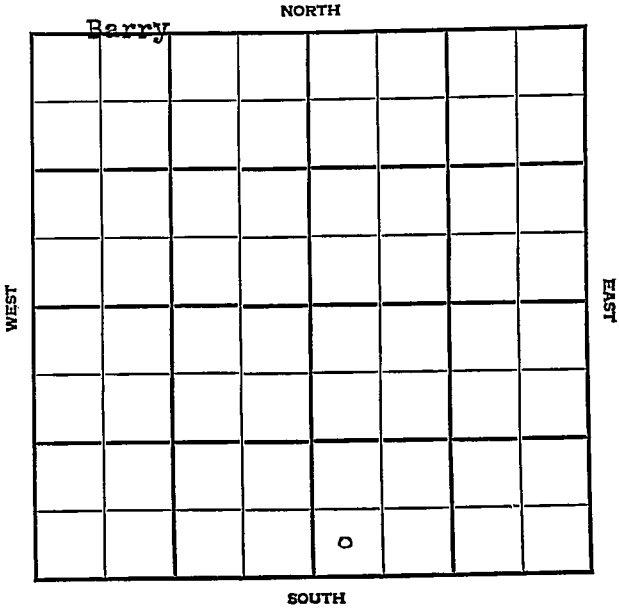

KANSAS Rocks

Sec. 2 Twp. 9 R. 19W

Well No. #8 Dan Barry "A" Farm

Continental Company

Barry


Ft. from N. Line

330 Ft. from S. Line

Ft. from E. Line

330 Ft. from W. Line

SW SE

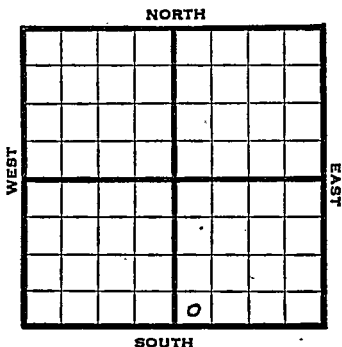

1947 , Elev. 1997' REPORT

- 10/1 Location
- 10/8 "
- 10/15 10" @ 206'
Drlg. 2600'
- 10/22 Lansing 3164'
Arbuckle 3419--
TD 3430'
6" @ 3420'
RUST
- 11/5 Arbuckle 3419'
6" @ 3420'
Echo Pot 3000
Gr. 27°
Total Depth 3430'

COMPLETED

Map No. _____ Sec. 2 Twp. 9 R. 19W

Well No. 8 Dan Barry "A"

Continental Company

FIRST REPORT

Contractor

SW SE

SECTION PLAT

_____ Ft. from N. Line

330 Ft. from S. Line

_____ Ft. from E. Line

330 Ft. from W. Line

Rooks County

Location X

Rig up _____

Drilling and Remarks:

RECORD

Cased _____ in., _____ ft.

Sand _____

Gas _____

Oil _____

Total Depth _____

PRODUCTION

1st 24 hrs. Nat. _____

1st 24 hrs. after shot _____

Gas _____ Cu. Ft.

Dry Hole _____

Abandoned _____

Date

OCT 1 1947 19

S. J. LEWIS Scout

