


Section 2 Township 9 Range 10

Well No. #4 Dan Barry "B"

Company Continental

13

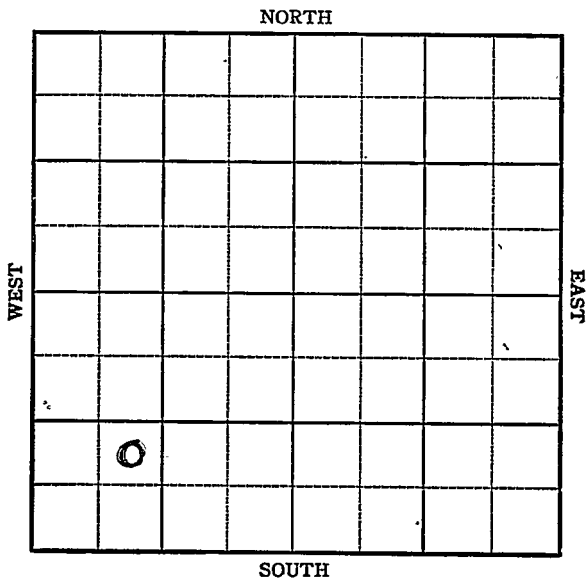

Sec. 2 Twp. 9 R. 19W

Well No. #4 Dan Barry "B" Farm  
Continental Company

Barry Pool


\_\_\_\_\_ Ft. from N. Line

990 Ft. from S. Line

\_\_\_\_\_ Ft. from E. Line

990 Ft. from W. Line

*U.S. 2019*

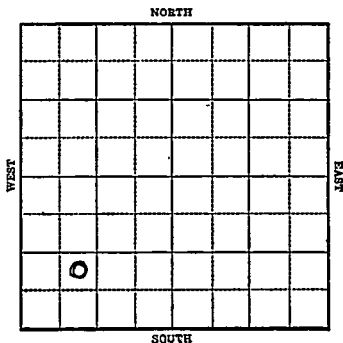

1944

R E P O R T

3/8 Location

3/16 Derrick

3/22 Derrick

3/29 "

4/5 Rotary

4/12 10" @ 241  
Drlg. 2160'

4/19 Arb 3425  
TD 3430 Sat  
Rung Csg.

4/26 SLM 3430-33  
Arb 3428  
6" @ 3430  
TD 3433  
Rust

5/3 "

5/10 "

5/17 T.D. 3454 - 2850' oil

OVER

1944

5/24

6" @ 3430

Arb 3428

TD 3433

Depth Pot 3000

Gravity 36.4

COMPLETED

KANSAS

Map No. 60 Sec. 2 Twp. 9 R. 19W

Well No. 4 Dan Barry "B"

Continental Company

FIRST REPORT Contractor

**NE SW SW**

**SECTION PLAT**

\_\_\_\_\_ Ft. from N. Line

990 Ft. from S. Line

\_\_\_\_\_ Ft. from E. Line

990 Ft. from W. Line


**Barry Pool**

Location X

Rig up \_\_\_\_\_

Drilling and Remarks:

**RECORD**

Cased \_\_\_\_\_ in., \_\_\_\_\_ ft.

Sand \_\_\_\_\_

Gas \_\_\_\_\_

Oil \_\_\_\_\_

Total Depth \_\_\_\_\_

**PRODUCTION**

1st 24 hrs. Nat. \_\_\_\_\_

1st 24 hrs. after shot \_\_\_\_\_

Gas \_\_\_\_\_ Cu. Ft.

Dry Hole \_\_\_\_\_

Abandoned \_\_\_\_\_

Date

MAR 8 1944 19

S. I. LEWIS Scout

