
O.W.W.O. KANSAS Rooks

FORM 51 5M PETROL

Section 2 Township 9 Range 19W

Well No. #4 J.E. Slansky

Company Continental Oil

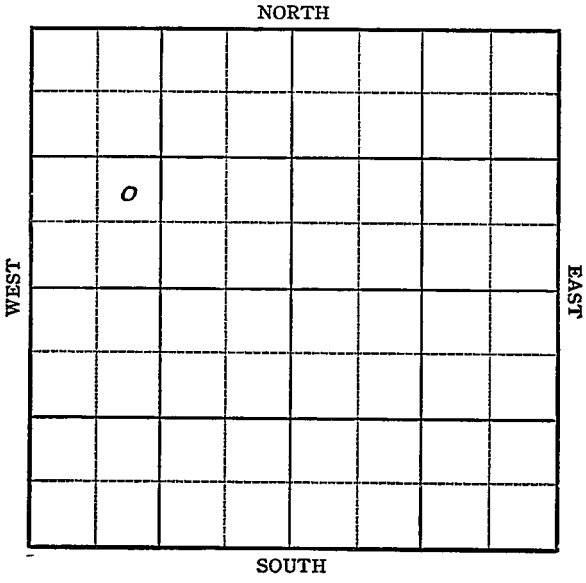

FORM 252-A
5M 9-43 GASSAS

O.W.W.O.

Rooks

Sec. 2 Twp. 9 R. 19W

Well No. #4 J. E. Slansky Farm

Continental Company

Barry


Ft. from N. Line

990 Ft. from S. Line

Ft. from E. Line

990 Ft. from W. Line

NE SW NW

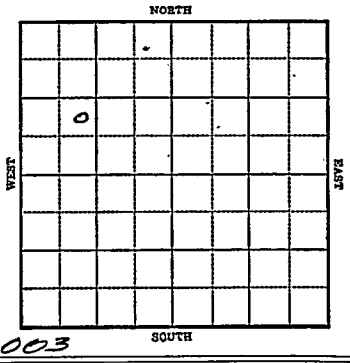

Elev. 2003

1944	REPORT
2/16	Derrick
2/23	Rotary
3/1	10" @ 243 Drlg. 2520'
3/7	Drlg. 3420
3/16	Arb 3433 TD 3434 6" @ 3433-200' oil 2 hrs.
3/22	Arb. 3433 6" @ 3433 1000 acid TD 3440 Pump 468 Pot Gravity 29.8

COMPLETED

OVER

1955
5/25

O.W.W.O.

Oil well TD 3438' OTD 3438'
6" @ 3432 Lans. 3163' Arb. 3433'
PB 3372 26/3354-64 1000 A
S/5 BO 5 BW 4 hr. CO to 3420
S/8 BO 4 BW 4 hr.
Comp. 26 BOPD 26 BW

FIRST REPORT

COMPLETED

Form 26 200 Bks 5-42 Petrol Rooks

KANSAS

Map No. 69 Sec. 2 Twp. 9 R. 19W


Well No. 4 J. E. Slansky

Continental Company

FIRST REPORT Contractor

NE SW NW

SECTION PLAT

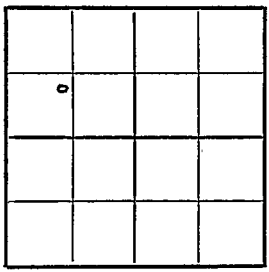

____ Ft. from N. Line

990 Ft. from S. Line

____ Ft. from E. Line

990 Ft. from W. Line

Barry Pool

Location

Rig up

Drilling and Remarks:

Derrick

RECORD

Cased ____ in., ____ ft.

Sand

Gas

Oil

Total Depth

PRODUCTION

1st 24 hrs. Nat.

1st 24 hrs. after shot

Gas ____ Cu. Ft.

Dry Hole

Abandoned

Date

FEB 16 1944 19

S. J. LEWIS Scout

Form 26 200 Bks 5-42 Petrol Rooks

KANSAS

Map No. 65 Sec. 2 Twp. 9 R. 19W


Well No. 4 J. E. Slansky

Continental Company

COMPLETED Contractor

NE SW NW

SECTION PLAT

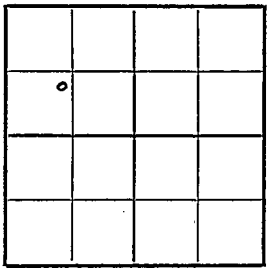

____ Ft. from N. Line

990 Ft. from S. Line

____ Ft. from E. Line

990 Ft. from W. Line

Barry Pool

Location

Rig up

Drilling and Remarks:

Cir & 3433

6 "@ 3433

1000 Gal @

Pump 468 BH

29 E Gas

RECORD

Cased ____ in., ____ ft.

Sand

Gas

Oil

Total Depth 3446

PRODUCTION

1st 24 hrs. Nat.

1st 24 hrs. after shot

Gas ____ Cu. Ft.

Dry Hole

Abandoned

Date

MAR 2 2 1944 19 S. J. LEWIS Scout

FORM 275 FOR SALE BY KANSAS BLUE PRINT CO.

O.W.W.O.


County Rooks State Kansas

Sec. 2 (Blk. / Twp.) 9 (Sur. / Rge.) 19W Map No.

Operator Continental Oil

Well No. 4 Farm J. E. Slansky

Elev. Location NE SW NW

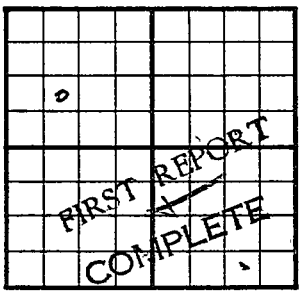

990 Ft. From S Line NW

990 Ft. From W Line Quarter

1st. Report MAY 2 5 1955

Completion

Remarks OWWO O.W.W.O.

Spudding Date

Drlg. Data Oil well TD 3438

OTD 3438 6" @ 3432 Lans. 3163

Arb. 3433 PB 3423 26/ 3376-3386

1000 A S/ 1 bw ½ bo 1 hr. PB 3372

26/ 3354-64 1000 A S/ 5 bo 5 bw 4 hr.

CO to 3420 S/ 8 bo 4 bw 4 hr.

Comp. 26 bopd 26 bw