


Section 2 Township 9 Range 19W

Well No. #9 J. E. Slansky

Company Continental Oil

*M*

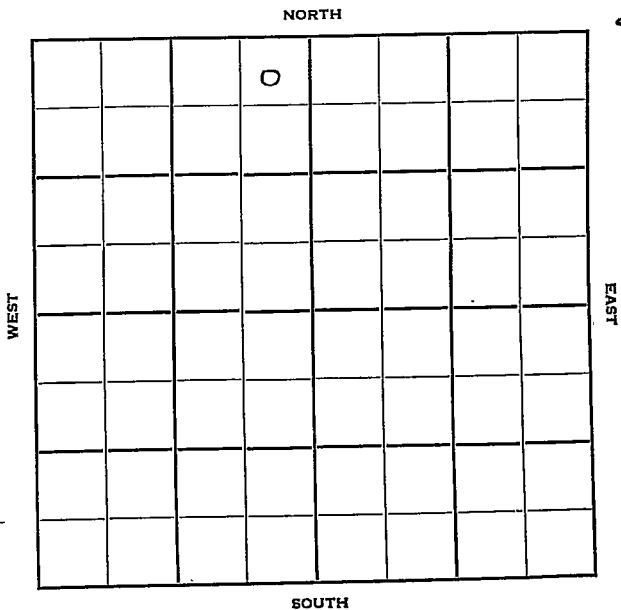

Sec. 2 Twp. 9 R. 19W

Well No. #9 J. E. Slansky Farm

Continental Oil Company

Lohman & Johnson- Contr. Contractor

Berry Pool


330' Ft. from N. Line

\_\_\_\_\_ Ft. from S. Line

330' Ft. from E. Line

\_\_\_\_\_ Ft. from W. Line

NE NE NW

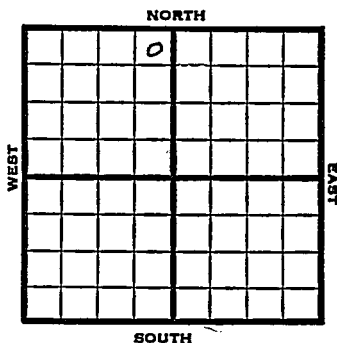

1951 Elev. 1965' REPORT

8/17 10" @ 206  
Drlg. 1603'  
Spud 8-17-51

11/14 Spud 8-17-51  
Oil well TD 3444' 10" @ 206'  
KC 3148' Arb. 3394'  
DST 3398-3404' open 1 hr. rec 12' SOCM  
TD 3444' 7" @ 3443 24/3390-98' SO  
500 A S/20 BOPH  
Comp. 466 BOPD

**COMPLETED**

County Rooks State Kansas

Sec. 2 (Blk. Twp.) 9 (Sur. Rge.) 19W Map No.

Operator Continental Oil

Well No. 9 Farm J. E. Slansky

Elev. \_\_\_\_\_ Location NE NE NW

			0			

330 Ft. From N Line NW

330 Ft. From E Line Quarter

1st. Report AUG 22 1951

Completion \_\_\_\_\_

Remarks \_\_\_\_\_

Lohman & Johnson - Contr.

Spudding Date 8-17-51

Drlg. Data Berry Pool

10" @ 206 drlg. 1603

J. E. TYRA

County \_\_\_\_\_ Rooks State Kansas  
 Sec. 2 (Blk. Twp.) 9 (Sur. Rge.) 19W Map No. \_\_\_\_\_  
 Operator Continental Oil  
 Well No. 9 Farm J. E. Salensky  
 Elev. 1965 Location NE NE NW

		o			

COMPLETE

330 Ft. From N Line NW  
330 Ft. From E Line Quarter  
 Ist. Report \_\_\_\_\_  
 Completion NOV 14 1951  
 Remarks Berry Pool  
Lohman & Johnson - Contr.  
 Spudding Date 8-17-51

Drilg. Data Oil well TD 3444  
10" @ 206 KC 3148 Arb. 3394 DST 3398-  
3404 open 1 hr. Rec. 12' socm TD 3444  
7" @ 3443 24/ 3390-98 SO 500 A  
S/ 20 boph Comp. 466 bopd

J. E. TYRA