


Section 2 Township 9 Range 25 W

Well No. #1 Richmeier

Company Empire Drlg.

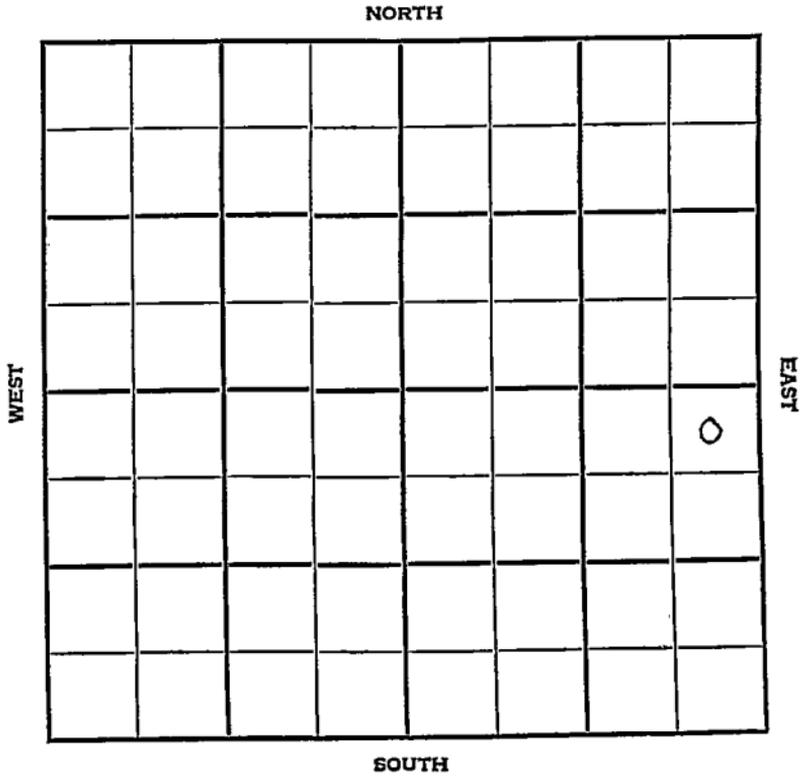

Graham

KANSAS

SEC. 2	TWP. 9	R.. 25W
-----------	-----------	------------

WELL NO.

#1 Richmeier
COMPANY

FARM

Empire Drlg.
CONTRACTOR

Col. Tools

Shiloh


_____ Ft. from N. Line

_____ Ft. from S. Line

_____ Ft. from E. Line

_____ Ft. from W. Line

NE NE SE

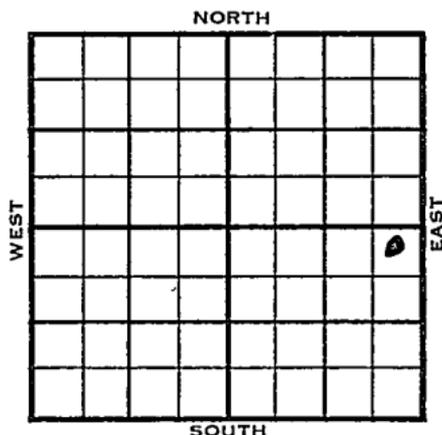

1955	ELEVATION 2546 KB	REPORT
------	----------------------	--------

8/3

Comm 7-26-55
8" @211/115 Drlg 3370
Anh. 2240**FIRST REPORT**

8/31

Comm 7-26-55
Anh 2240
H 3827
Tr ~~3850~~ 3850
L 3869
TD 40708" @ 211/115
5 1/2" @ 4064
GO to 4070

B/20 goph 5 hr 3000 A 2000 A

S/1 1/2 boph 28 hr

DST 4050-70 open 2 hr Rec 85' vhoem
240/30"DST 3890-3927 open 3/4 hr Rec 10' mud
spk oil 540/20"DST 3990-4055 open 1 hr Rec 20' mud
120/20"

Comp 91 bopd

COMPLETED

County Graham Elev. 2546 KB
 Sec. 2 Twp. 9 Rge. 25W
 Company Empire Drlg.
 Farm Name Richmeier No. 1

TOPS	DEPTH	LOG	DATUM
Anh.	2240		
Tp.			
H.			
Tr.			
Dg.			
Bl.			
L.			
K.C.			
B.K.C.			
Ce.			
C.			
M.			
M.			
K.			
Mz.			
Ms.			
V.			
S.			
S.			
A.			
R.			
PE.			
G.			
T.D.			

Loc. in Sec. NE NE SE

Geol. _____

Contr. _____

Co. tools _____

Pool _____

Shiloh

FIRST REPORT
 AUG 3 55


Date Comm. 7-26-55
8" @ 211/115 drlg. 3370

[Handwritten signature]

Co.
 Lse.
 No.
 Sec.
 T.
 R.

County Graham Elev. 2546
 Sec. 2 Twp. 9 Rge. 25W
 Company Empire Drlg.
 Farm Name Richmeier No. 1

TOPS	DEPTH	LOG	DATUM
Anh.	2240		
TP.			
H.	3827		1281
Tr.	3850		1304
Dg.			
Bl.			
L.	3869		1323
K.C.			
B.K.C.			
Ce.			
C.			
M.			
M.			
K.			
Mz.			
Mo.			
V.			
S.			
S.			
A.			
R.			
PE.			
G.			
T.D.	4070		

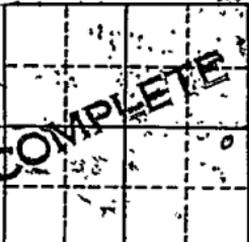Loc. in Sec. NE NE SE
 Geol. _____
 Contr. _____
 Co. tools _____
 Pool Shiloh


Date Comm. 7-26-55 AUG 31 1955
8" @ 211/115 5 1/2" @ 4064 GO. to 4070
B/ 20 goph 5 hr. 3000 A 2000 A
S/ 2 1/2 boph 28 hr. DST 4050-70
open 2 hr. Rec. 85' vhocm 240/30"
DST 3890-3927 open 3/4 hr. Rec. 10' mud
spk oil 540/20" DS" 3990-4055
open 1 hr. Rec. 20' mud 120/20"
Comp. 91 bopd

Co.
 Sec.
 No.
 Sec.
 T.
 R.