

Section 20 Township 9 Range 16-WWell No. #1 DorrCompany Cities Service Oil

					0		

NORTH

Wildcat

WEST

EAST

SOUTH

Sec. 20 Twp. 9 R. 16-WWell No. #1 Dorr FarmCities Service Oil Company
(Wildcat)330

Ft. from N. Line

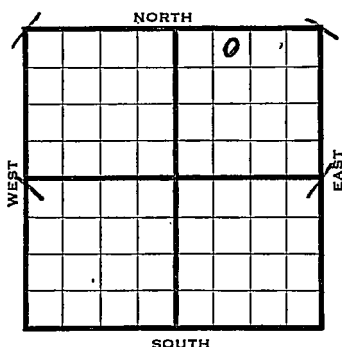
Ft. from S. Line

Ft. from E. Line

990

Ft. from W. Line

Elev. 2027



1942

REPORT

6/24	Location
7/1	8" - 203' Drlg. 1535'
7/8	Drlg. 2973'
7/15	Lans. 3145' S.O. 3194-3201' 3252-60' Arb. 3474' T.D. 3504' 4" - 3300' RUST.
7/22	75 shots, 3195-3254' Bail $\frac{1}{2}$ bbl. oil & $\frac{1}{2}$ bbl. water per hour. Shut down.
7/29	5000 acid. Temp. Pot. 47 bbls
8/5	" " " "
8/12	" " " "
8/19	" " " "
8/27	" " " "
9/2	" " " "
9/9	Lans. 3145 Arb 3474 4" - 3300 PB 3200 T.D. 3504 36 shots 3188-99 5000 acid pump 141 oil & 27 water Gravity 35.5

COMPLETED

Rooks

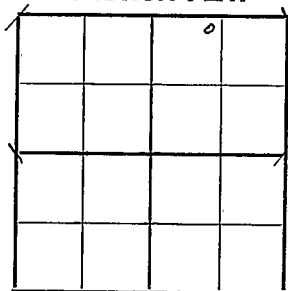
KANSAS

Map No. 64 Sec. 20 Twp. 9 R. 16WWell No. 1 DorrCities Service Oil Company
FIRST REPORT

Contractor

NE NW NE

SECTION PLAT

330 Ft. from N. Line Ft. from S. Line Ft. from E. Line990 Ft. from W. Line

WILDCAT

Location XXXRig up

Drilling and Remarks:

RECORD

Cased in., ft.Sand Gas Oil Total Depth

PRODUCTION

1st 24 hrs. Nat. 1st 24 hrs. after shot Gas Cu. Ft.Dry Hole Abandoned

Date

JUN 24 1942

19

S. J. LEWIS

Scout

KANSAS

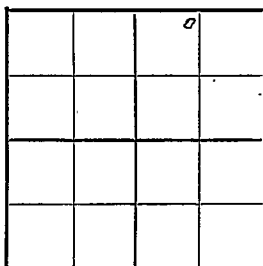
Rooks

Map No. 64 Sec. 20 Twp. 9 R. 16WWell No. 1 DorrCities Service Oil CompanyCOMPLETED

Contractor

NE NW NE

SECTION PLAT

330 Ft. from N. Line Ft. from S. Line Ft. from E. Line990 Ft. from W. LineDORR POOLLocation Rig up

Drilling and Remarks:

Loss 3145Per 24744" @ 3300PB 320036 & 40 ft 3178-995000 ccialPer 141 oil 727 water

Date

355/84

RECORD

Cased in., ft.Sand Gas Oil Total Depth 3504

PRODUCTION

1st 24 hrs. Nat. 1st 24 hrs. after shot Gas Cu. Ft.Dry Hole Abandoned

SEP 9 1942

19

S. J. LEWIS Scout