


DX 78-1 Rooks

Section 20 Township 9S Range 16W

Well No. #5 Dorr "A"

Company Cities Service

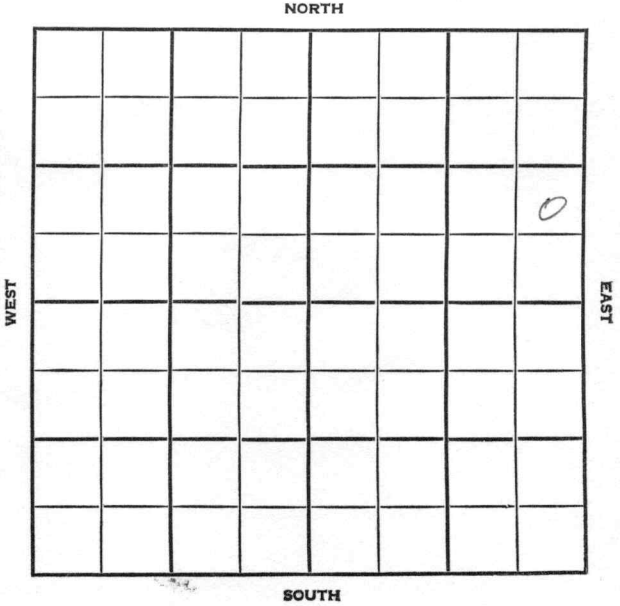

SEC. 20	TWP. # 9	R. 16W
------------	-------------	-----------

WELL NO.

#5 Dorr "A"

FARM

COMPANY

Cities Service

CONTRACTOR

Brader Drlg.


_____ FT. FROM N. LINE

_____ FT. FROM S. LINE

_____ FT. FROM E. LINE

_____ FT. FROM W. LINE

NE SE NE

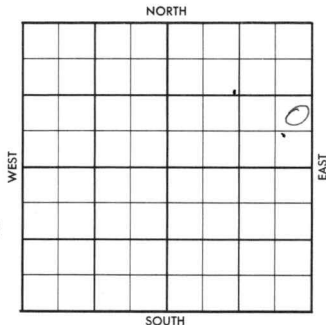

	ELEVATION	REPORT
1956	2033 DF	

8-15 Comm. 8-12-56
8" @ 245 w/175
Drlg. 1940

9-5 Comm 8-12-56
8" @ 245 w/175

Tops:

Tp 2902

H 3125

Dodge 3143

L 3168

BKC 3422

TD 3435

DST 3252-80 1 hr 120' M & W

970/30" 5 1/2 @ 3434/175

CO 3424 393/3145-3415

P 132 BO + 85 BW 24 hrs


COMPLETED

County Rocks Elev. 2033 DF
 Sec. 20 Twp. 9S Rge. 16W
 Company Cities Service
 Farm Name Dorr "A" No. 5

TOPS	DEPTH	LOG	DATUM	Loc. in Sec.
Anh.				NE SE NE
Tp.				
H.				
Tr.				
Dg.				
BL.				
L.				Geol.
K.C.				Contr.
B.K.C.				Brader Drlg.
Ce.				
C.				Pool
M.				Dorr
M.				
K.				
Mz.				
Mq.				
V.				
S.				
S.				
A.				
R.				
PE.				
G.				
T.D.				

Date Comm. 8-12-56
8" 245 w/175; D 1940

AUG 15 '56

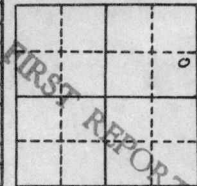

R.G.

County Rooks Elev. 2033 DF
 Sec. 20 Twp. 9S Rge. 16W
 Company Cities Service
 Farm Name Dorr "A" No. 5

TOPS	DEPTH	LOG	DATUM	Loc. in Sec.
Anh.				NE SE NE
TP.	2902			
H.	3125			
Tr.				
Dg. <u>Dodge</u>	3143			
BL.				
L.	3168			Geol.
K.C.				Contr.
B.K.C.	3422			Brader Drlg.
Ce.				<u>42.8</u>
C.				Pool
M.				Dorr
M.				
K.				
Mz.				
Ma.				
V.				
S.				
S.				
A.				
R.				
PE.				
G.				
TD.	3435			

COMPLETE

56

Date Comm. 8-12-568" 245 w/175; D 1940

AUG 22 '56

DST 3252-80 16 120' M SW970/30" AUG 29 '56 5 1/2 3434/175CO 3424 SEP 5 '56 393/3145-3415 110 R. 132Bo + 85 BW 24 hrs.