

KANSAS


Rooks

FORM 51 5M BRIX

Section 20 Township 9 Range 17W

Well No. #1, E. C. Ganoung

Company Barnsdall

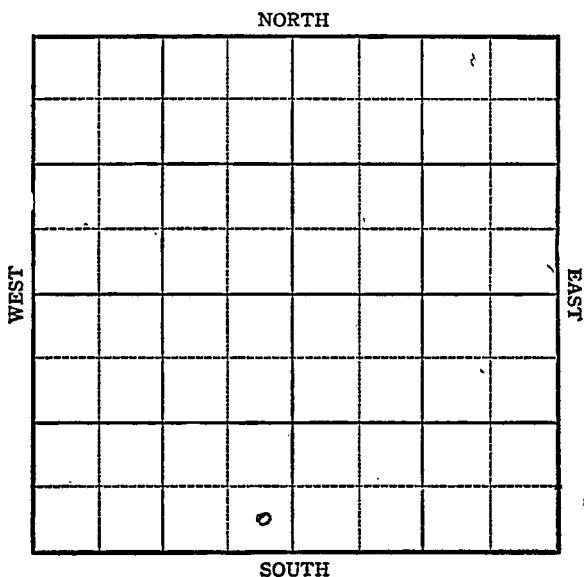

KANSAS

Rooks

Sec. 20 Twp. 9 R. 17W

Well No. #1, E.C. Ganoung Farm

Barnsdall Company


Wildcat

 Ft. from N. Line

330 Ft. from S. Line

330 Ft. from E. Line

 Ft. from W. Line

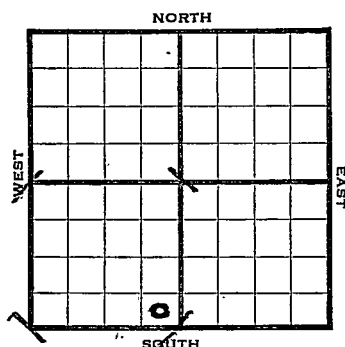

1944

R E P O R T

5/31 **Location**

6/7 10" @ 125'
Drlg. 1290'

6/21 Lans 3275
Cong. 3555
Simp. 3610
Arb. 3648
E.D. 3698

ABANDONED

KANSASPool Name WildcatMap No. 10 Sec. 20 Twp. 9 R. 17WWell No. 1 E. C. GanoungBarnsdall

Company

FIRST REPORT

Contractor

SE SW

SECTION FLAT

Ft. from N. Line

330

Ft. from S. Line

330

Ft. from E. Line

Ft. from W. Line

Rooks CountyLocation X

Rig up

Drilling and Remarks:

RECORD

Cased _____ in., _____ ft.

Sand _____

Gas _____

Oil _____

Total Depth _____

PRODUCTION

1st 24 hrs. Nat. _____

1st 24 hrs. after shot _____

Gas _____ Cu. Ft.

Dry Hole _____

Abandoned _____

Date

MAY 3 1 1944

19

S. J. LEWIS

Scout

Pool Name Wildcat

KANSAS

Map No. 124 Sec. 20 Twp. 9 R. 17WWell No. 1 E. C. GanoungBarnsdall

Company

ABANDONED

Contractor

SE SW

SECTION PLAT

_____ Ft. from N. Line

330 Ft. from S. Line330 Ft. from E. Line

_____ Ft. from W. Line

Rooks County

Location _____

Rig up _____

Drilling and Remarks:

Trans 3225.
Cor. g 3555
Surf 3610
Cr 3648

RECORD

Cased _____ in., _____ ft.

Sand _____

Gas _____

Oil _____

Total Depth 3648

PRODUCTION

1st 24 hrs. Nat. _____

1st 24 hrs. after shot _____

Gas _____ Cu. Ft.

Dry Hole _____

Abandoned _____

Date

JUN 21 1944 19S. J. LEWIS Scout