
FORM 51 25M 8-50 WESTERN Rooks

KANSAS

Section 20 Township 9 Range 17W

Well No. #1 Ganoung

Company Dizdar Investment

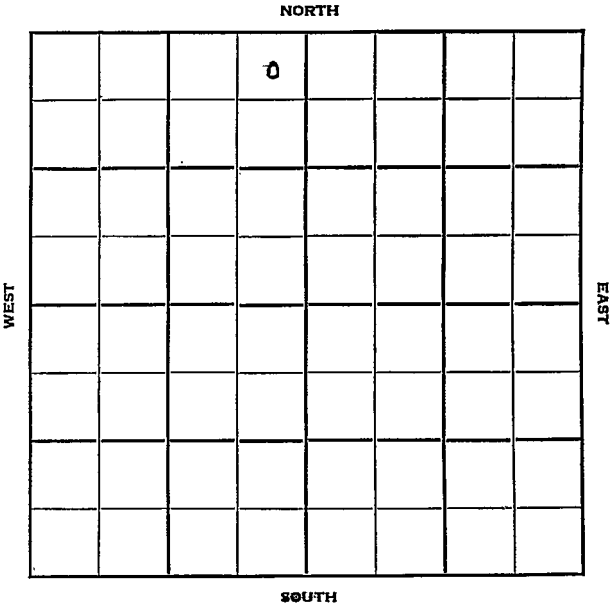

FORM 252-B
10M 10-50 PETROL

Rooks

KANSAS

Sec. 20 Twp. 9 R. 17W

Well No. #1 Ganoung Farm

Dizdar Investment Company

Contractor

Wildcat


330 Ft. from N. Line

Ft. from S. Line

330 Ft. from E. Line

Ft. from W. Line

NE NE NW

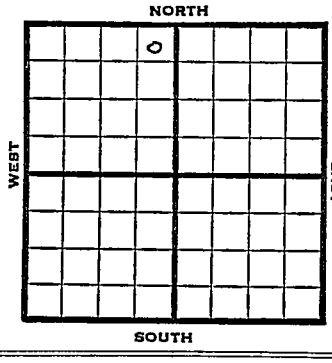

1952	Elev. 2091' REPORT
1/2	Spud 12-27-51 8" @ 106' WOC
1/16	Spud 12-27-51 D&A TD 3620' 8" @ 106 Heeb 3255 Lans. 3296 DST 3455-3500 open 45 min. rec. 25' mud DST 3560-80 open 1 hr. rec. 15'mud Arb. 3601-20 TD D&A

ABANDONED

FORM 275 FOR SALE BY KANSAS BLUE PRINT CO.


County Rooks State Kansas

Sec. 20 (Blk. Twp.) 9 (Sur. Rge.) 17W Map No.

Operator Dizdar Investment

Well No. 1 Farm Canoung

Elev. Location NE NE NW

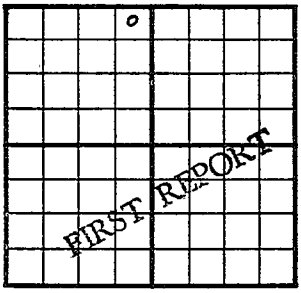

330 Ft. From N Line NW

330 Ft. From E Line Quarter

1st. Report JAN 2 1952

Completion

Remarks

Spudding Date 12-27-51

Drlg. Data Wildcat

8" @ 106 WOC

J. E. TYRA

FORM 275 FOR SALE BY KANSAS BLUE PRINT CO.


County Rooks State Kansas

Sec. 20 (Blk. Twp.) 9 (Sur. Rge.) 17W Map No.

Operator Dizdar Investment

Well No. 1 Farm Ganoung

Elev. 2091 Location NE NE NW

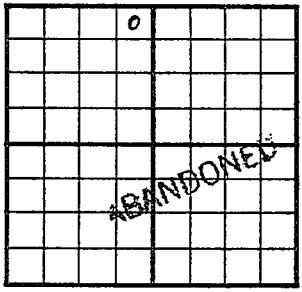

330 Ft. From N Line NW

330 Ft. From E Line Quarter

1st. Report

Completion JAN 1 6 1952

Remarks Wildcat

Spudding Date 12-27-51

Drlg. Data D & A TD 3620

8" @ 106 Heeb. 3255 Lans. 3296

DST 3455-3500 Open 45 min. Rec. 25' mud

DST 3560-80 open 1 hr. Rec. 15' mud

Arb. 3601-20 TD

D & A

J. E. TYRA