


Section 20 Township 9 Range 18 W

Well No. # 1 Brungartner "B"

Company Heathman & Co.

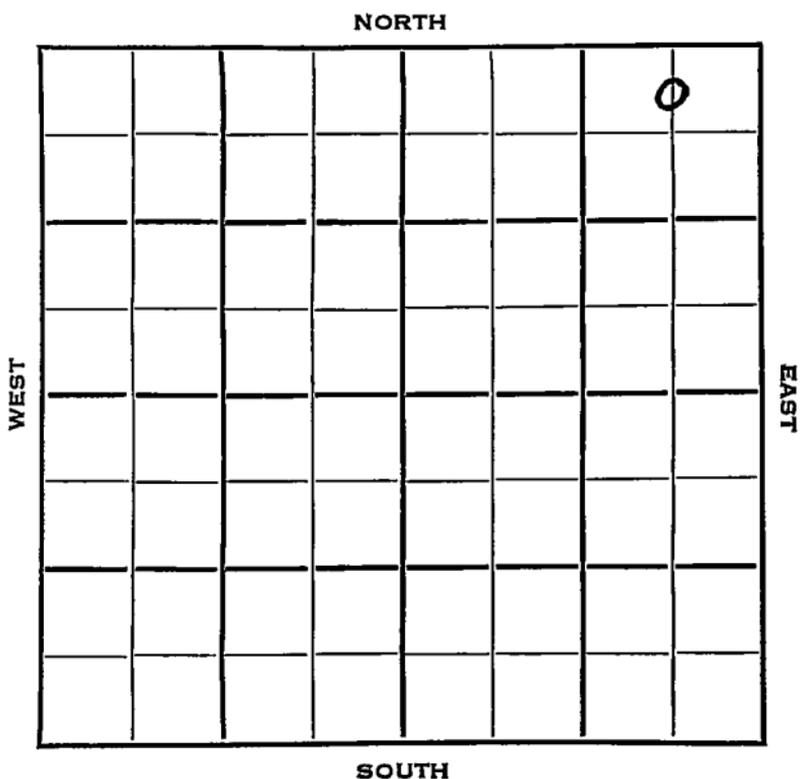



1953

Information brought forward.

11/18 DST 3587'-96' opn 1 hr, rec 1740' oil  
1010#  
DST 3598'-3604' opn 1 hr, rec 1800'  
oil 1010#  
DST 3604'-14' opn 1 hr, rec 2130'  
oil 820#  
DST 3614'-30' opn 1 hr, rec 2000'  
fluid 50% wtr.  
TD 3640'  
5" @ 3639'  
CO to 3638'  
12/ 3624-27 24/ 3627-33 FU 200' wtr  
 $\frac{1}{2}$  hr. 40/ 3614-24 20/ 3615-20  
FU 300' oil 1900' wtr. 3 hr.  
CO to 3607'  
30/ 3600-05 FU 2000' oil  $2\frac{1}{2}$  hr.  
S/ 32 boph 2 hr. 36/ 3594-3600  
S/  $13\frac{1}{2}$  boph 3 hr. S/ 25 bo 1 hr.  
PB 3588  
40/ 3580-87 FU 300' oil 1 hr.  
B/ 9 boph & SSW 500 A S/ 20 boph  
Comp 2979 bopd.

**COMPLETED**


County \_\_\_\_\_ Rocks \_\_\_\_\_ State Kansas

Sec. 20 (Blk.) \_\_\_\_\_ (Sur.) \_\_\_\_\_ (Twp.) 9 (Rge.) 18W Map No. \_\_\_\_\_

Operator Heathman & Co.

Well No. 1 Farm Brungartner "B"

Elev. \_\_\_\_\_ Location C N L NE NE

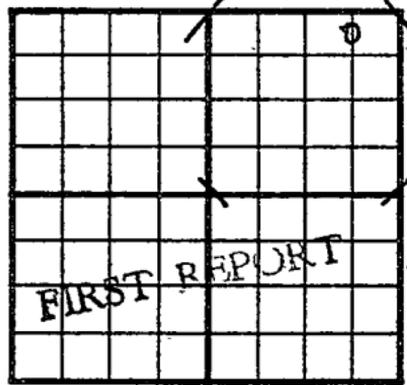

330 Ft. From N Line NE

660 Ft. From E Line Quarter

Ist. Report SEP 9 1953

Completion \_\_\_\_\_

Remarks CSO farmout

Walters Drig. - Contr.

Spudding Date 9-5-53

Drig. Data \_\_\_\_\_

8" @ 163 Anhy 1502 drig. 1814



Drlg. Data

40/ 3614-24 20/ 3615-20 FTU 300' oil

1900' wtr. 3/ hr. 000to 3607

30/ 3600-05 FTU 2000' oil 2 1/2 hr.

S/ 32 boph 2 hr. W 367-3594-3600

S/ 15 1/2 boph 3 hr. S/ 25 bo 1 hr.

PB 3588 240/ 3580-87 FTU 300' oil 1 hr.

B/ 9 boph & SSW 500 A S/ 20 boph

Comp. 2.979 bopd